


T.17S.R.7W.W.M.

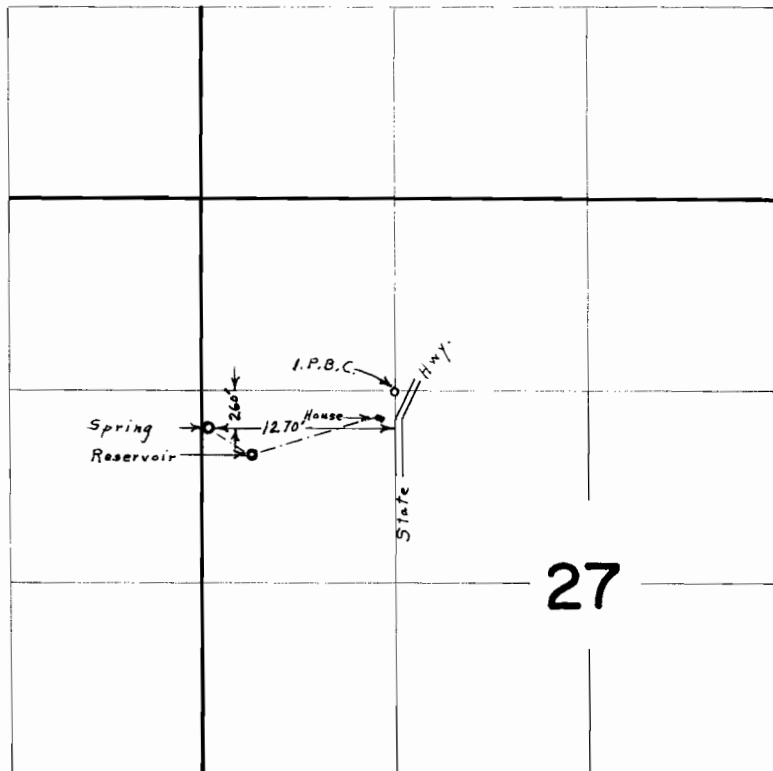

FINAL PROOF SURVEY
UNDER

Application No. 39453 Permit No. 29386
IN NAME OF
CARL O. TOLL

Surveyed July 19, 1967, by L. E. Gould