


T.15S.R.6W.W.M.

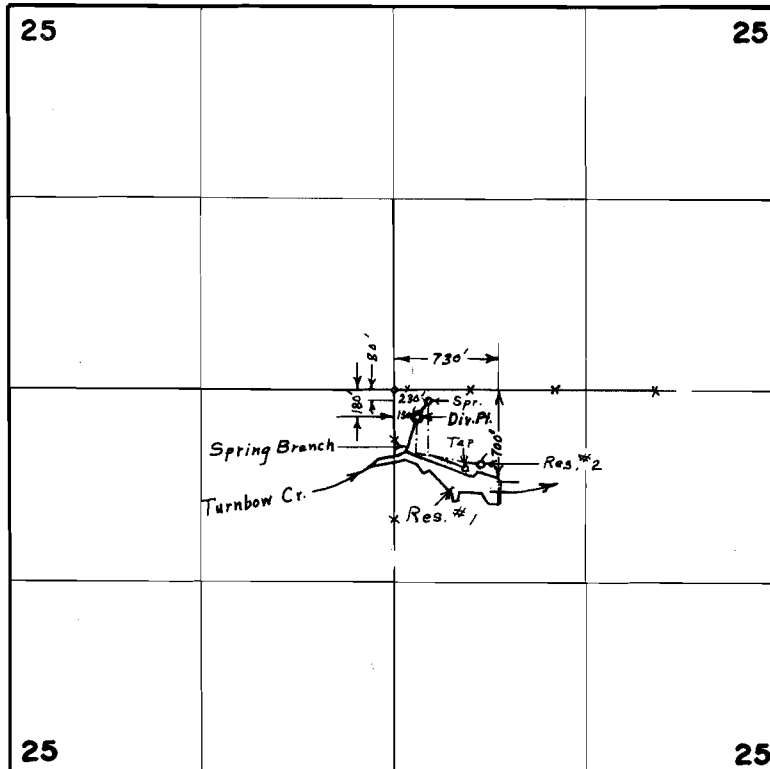

FINAL PROOF SURVEY
UNDER

R-40589 R-4558
Application No. 40590 Permit No. 30309
IN NAME OF
E. R. NEIL

Surveyed April 28, 1967, by L. E. Gould