


T.15S.R.6W.W.M.

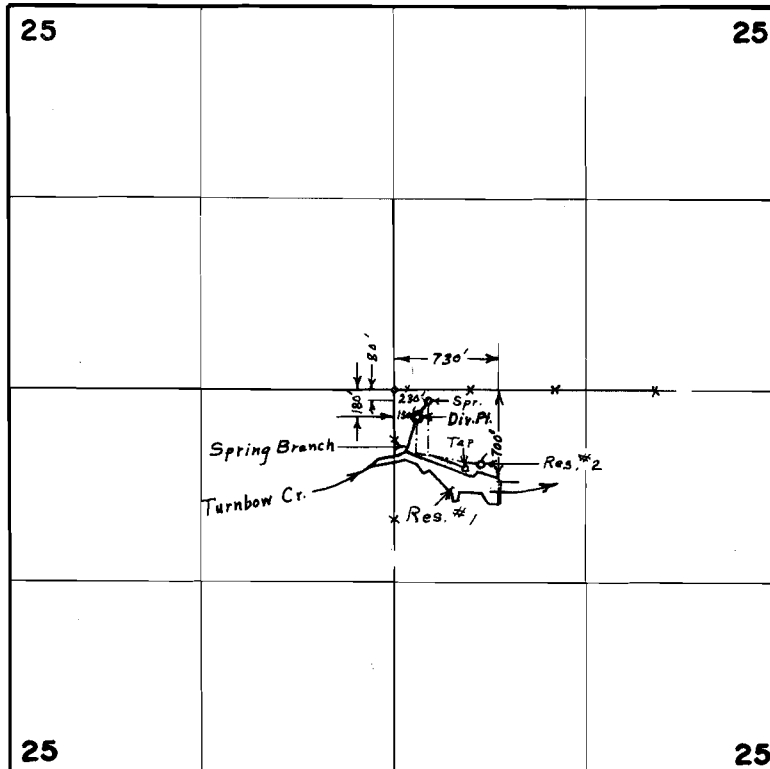

FINAL PROOF SURVEY
UNDER

R-40589 *R-4558*
Application No. *40590* Permit No. *30309*
IN NAME OF
E. R. NEIL

Surveyed *April 28, 1967*, by *L. E. Gould*