


T.17S.R.4&5W.W.M.

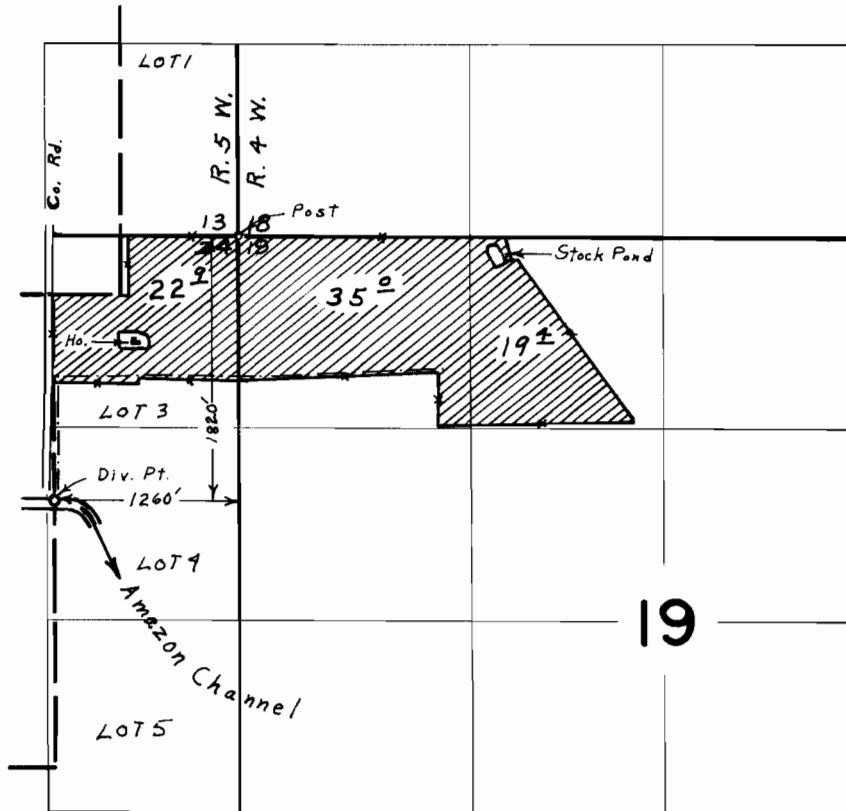

FINAL PROOF SURVEY
UNDER

Application No. 41560 Permit No. 30790
IN NAME OF
GEORGE K. LOWE

Surveyed May 8, 1967, by L. E. Gould