


T.17S.R.6 W.W.M.

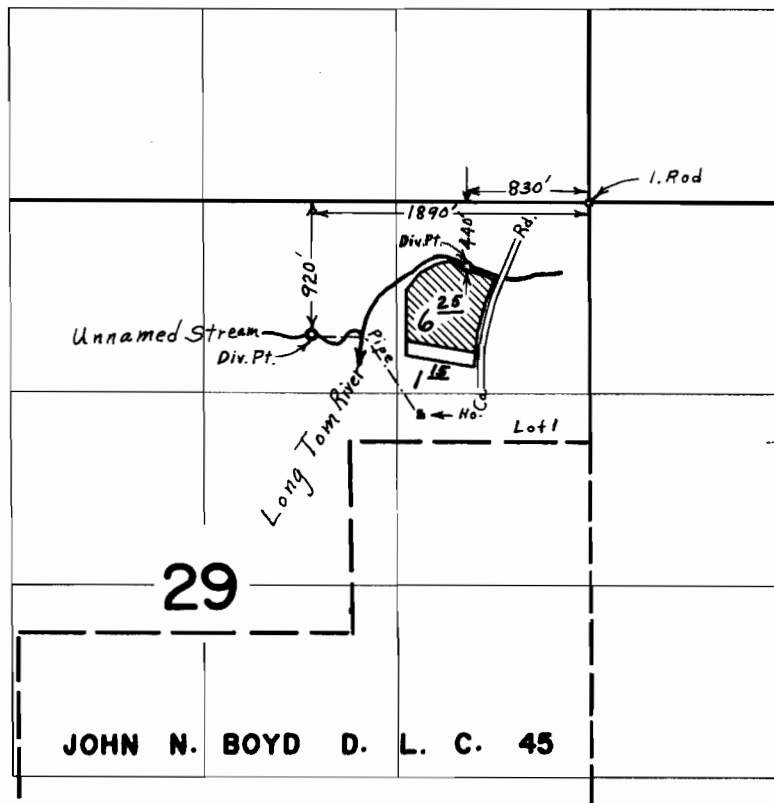

**FINAL PROOF SURVEY**  
UNDER

Application No. 42668 Permit No. 31887  
IN NAME OF  
**G. LOUIS WRIGHT**

Surveyed July 19, 1967. by L. E. Gould