


T. 9 S. R. 11 W. W. M.

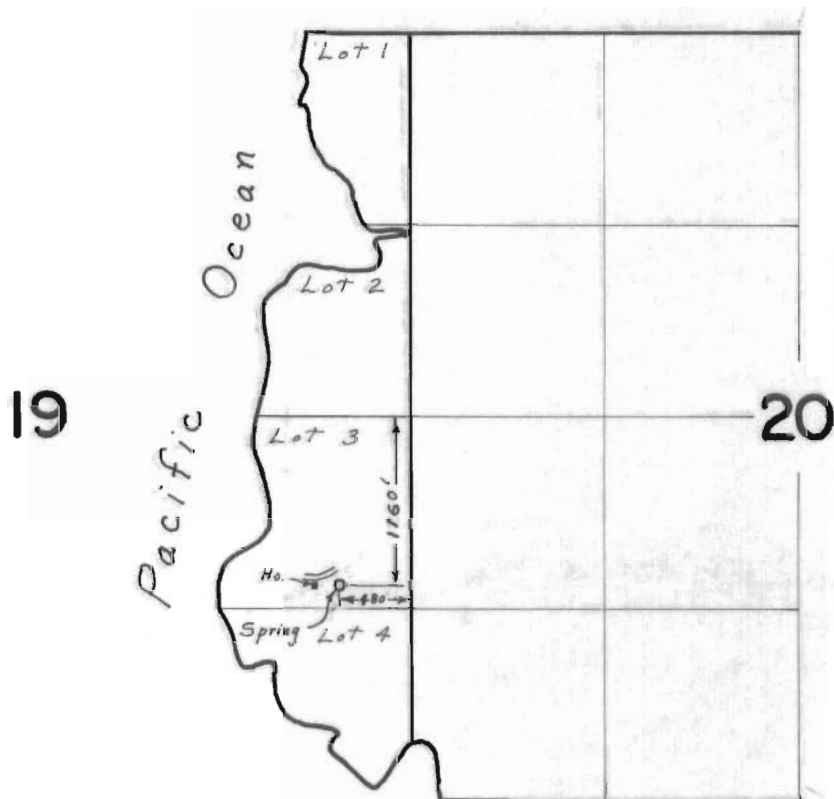

**FINAL PROOF SURVEY**  
UNDER

Application No. 39281 Permit No. 29256  
IN NAME OF  
**GEORGE J. COPELAND**

Surveyed Sept. 27, 1967, by L. E. Gould