


T.14 & 15 S. R. 11 W. W.M.

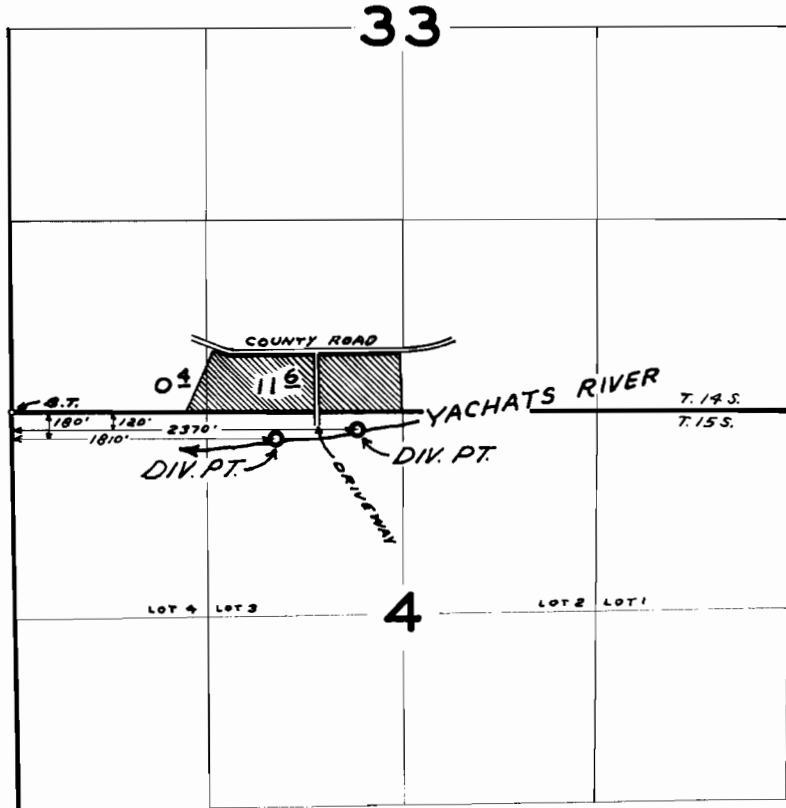

FINAL PROOF SURVEY
UNDER

Application No. 41625 Permit No. 31068
IN NAME OF

LESTER HALL

Surveyed AUG. 23 1966, by L. GOULD
Aug 18 1967