


T.14S.R.40E.W.M.

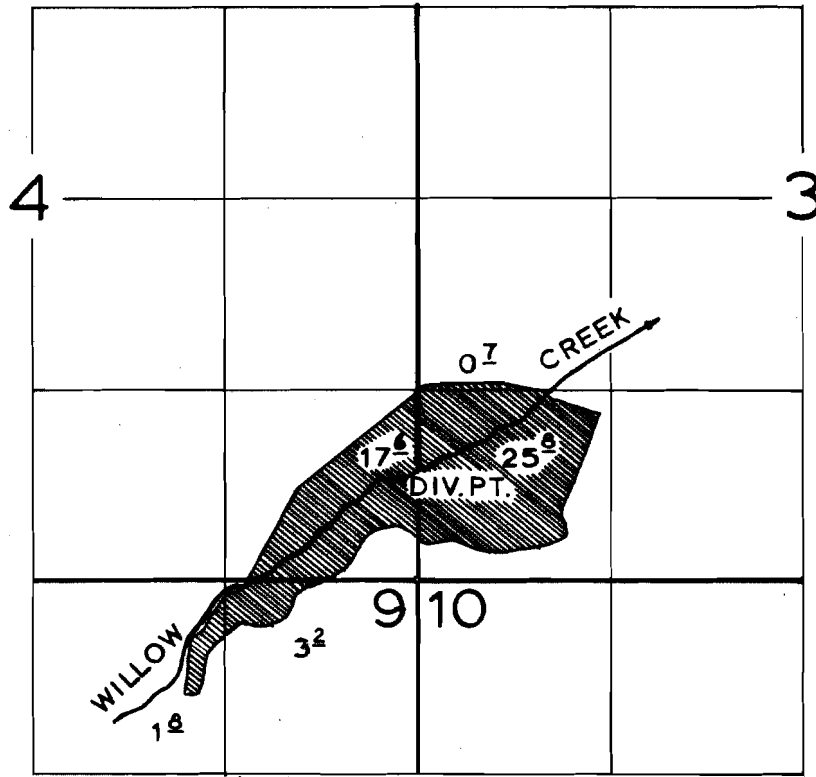

DIV. PT. IS 700' N. § 100' W. FROM SE. COR. SEC. 4

FINAL PROOF SURVEY
UNDER

Application No. 41798... Permit No. 31112.....
IN NAME OF

THOMAS J. BRONSON

Surveyed MARCH 20, 1968, by E. ELFERING.....