


T. 8 S. R. 1 W. W. M.

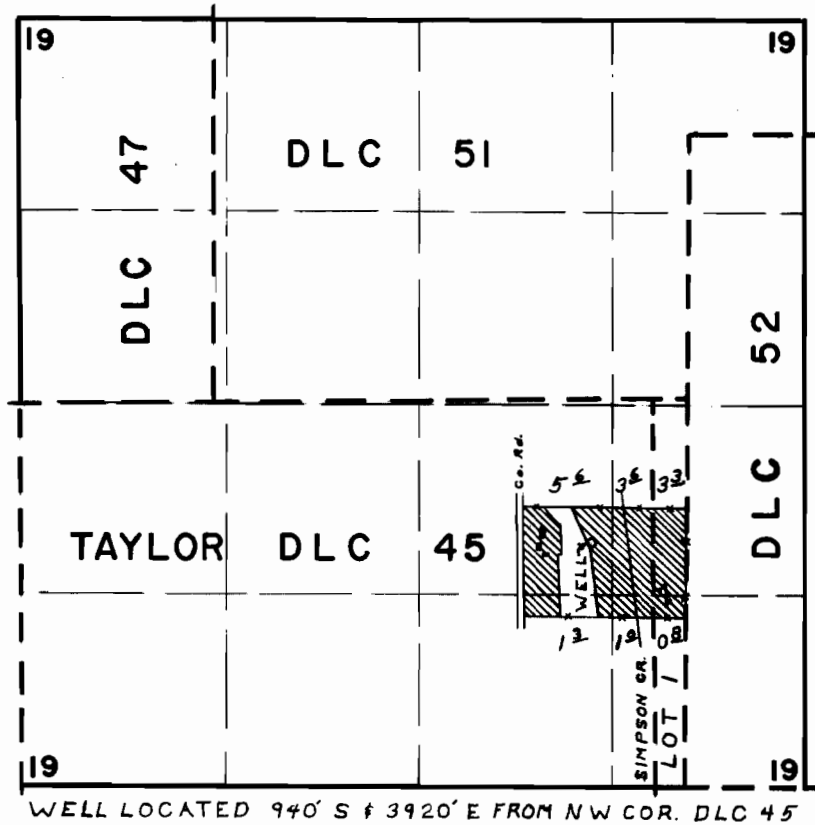

FINAL PROOF SURVEY UNDER

Application No. 6-3210 Permit No. 6-3026
IN NAME OF

F. W. STRAWN

Surveyed JULY 25 1968, by L. E. GOULD