


# T. 7 S. R. 1 & 2 E. W. M.

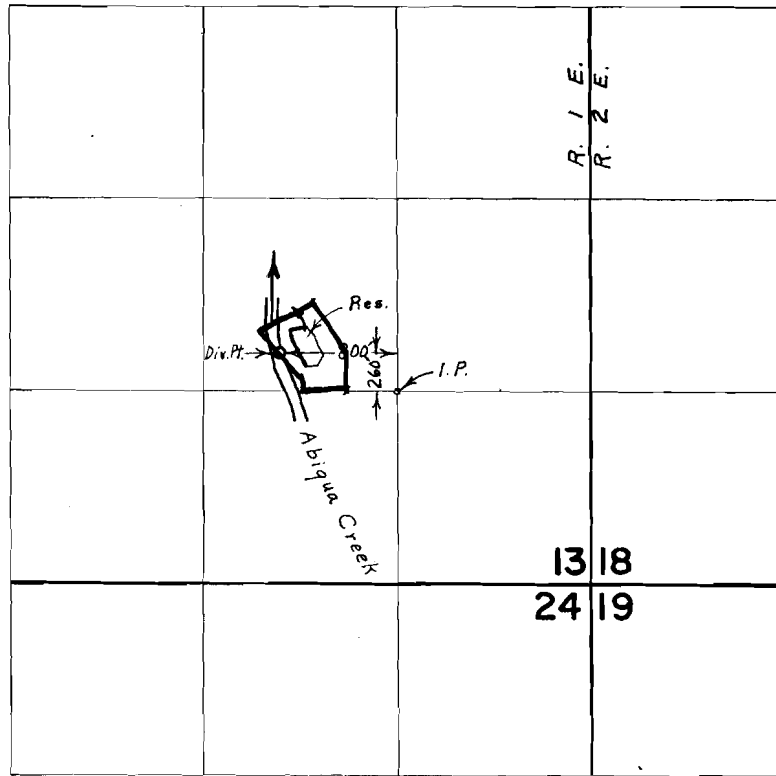

## FINAL PROOF SURVEY UNDER

Application No. <sup>R-40524</sup> 40525 Permit No. <sup>R-4527</sup> 30184  
IN NAME OF

**HARRY C. PICHETTE**

Surveyed *Nov. 1, 1967,* by *Ralph Jackson*