


# T. 9 S. R. 5 W. W.M.

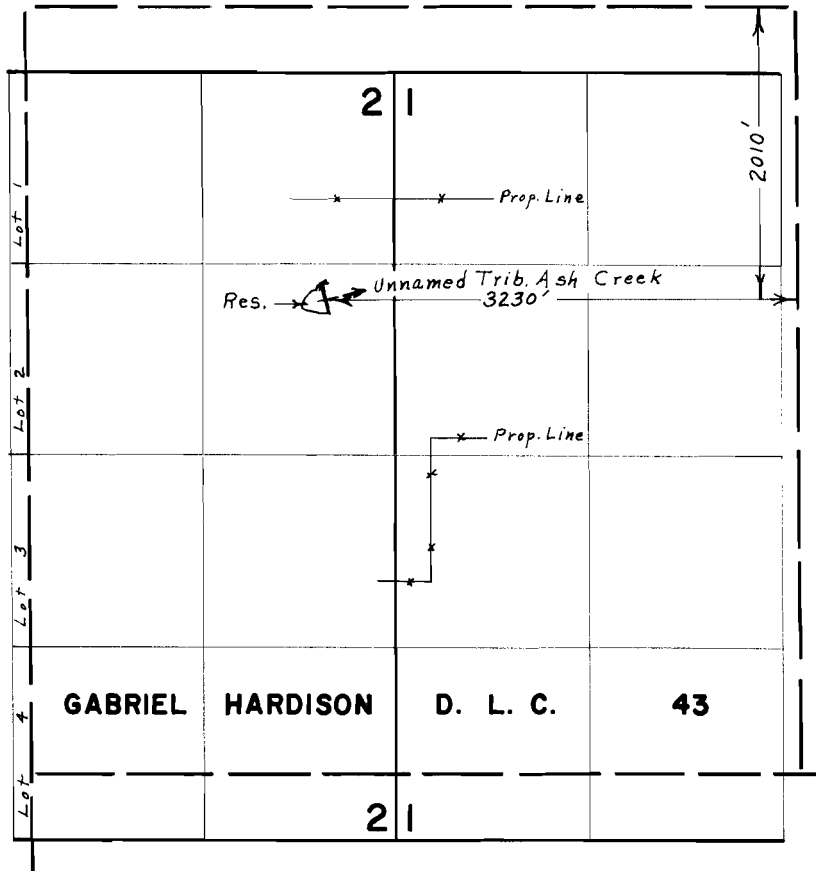

## FINAL PROOF SURVEY UNDER

Application No. *R-41681* Permit No. *R-4703*  
IN NAME OF

**JOHN W. LAMERS**

*Mar. 31 1966 W.J. Ruppert*  
Surveyed *Oct. 31, 1967*, by *L.E. Gould*