


# T.3N.R.28E.W.M.

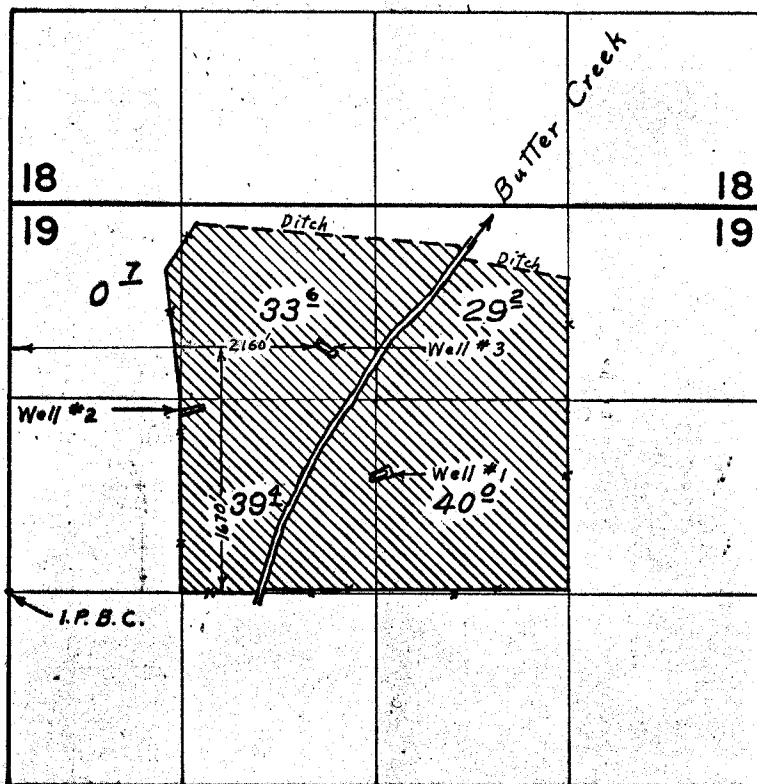

## FINAL PROOF SURVEY UNDER

Application No. G-2786 Permit No. G-2597  
IN NAME OF  
**FRED E. DAVIS**

Surveyed June 22, 1967, by L. E. Gould