


T.4N. R.27&28 E.W.M.

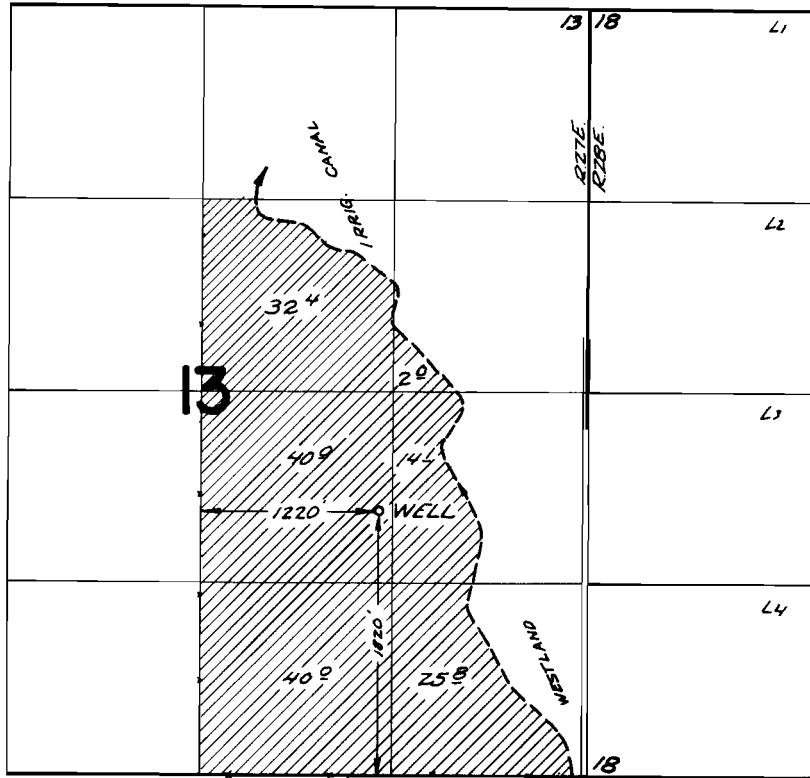

FINAL PROOF SURVEY UNDER

Application No. G-2809 Permit No. G-2620
IN NAME OF

FLOYD A. OMAN

Surveyed June 22 1967, by L. E. Sevid