


# T.3N.R.27E.W.M.

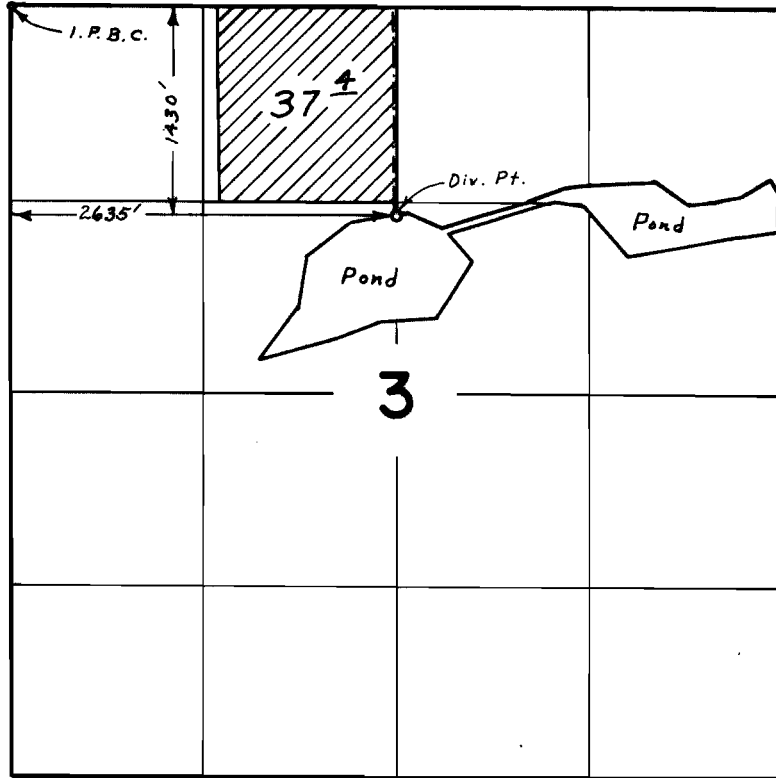

## FINAL PROOF SURVEY UNDER

Application No. 41908 Permit No. 31266  
IN NAME OF  
**J. D. STEINBECK**

Surveyed June 29, 1967, by L. E. Gould