


T.I.S. R.2.W.W.M.

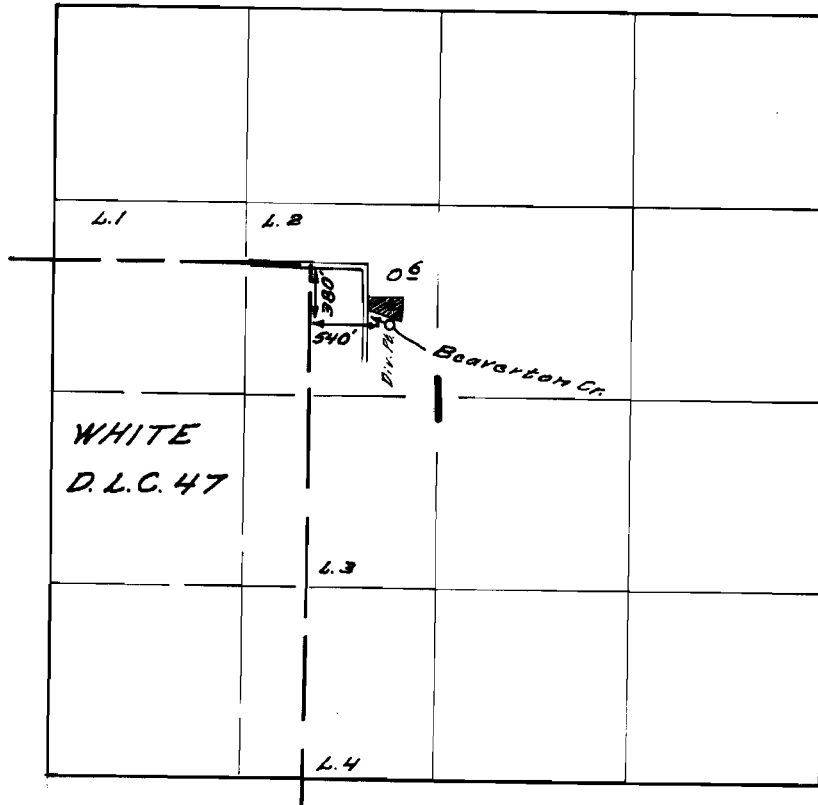

FINAL PROOF SURVEY
UNDER

Application No. 37043 Permit No. 27566
IN NAME OF

GLEN R GORDON

Surveyed Aug 16 1967, by W. J. Ruppert