


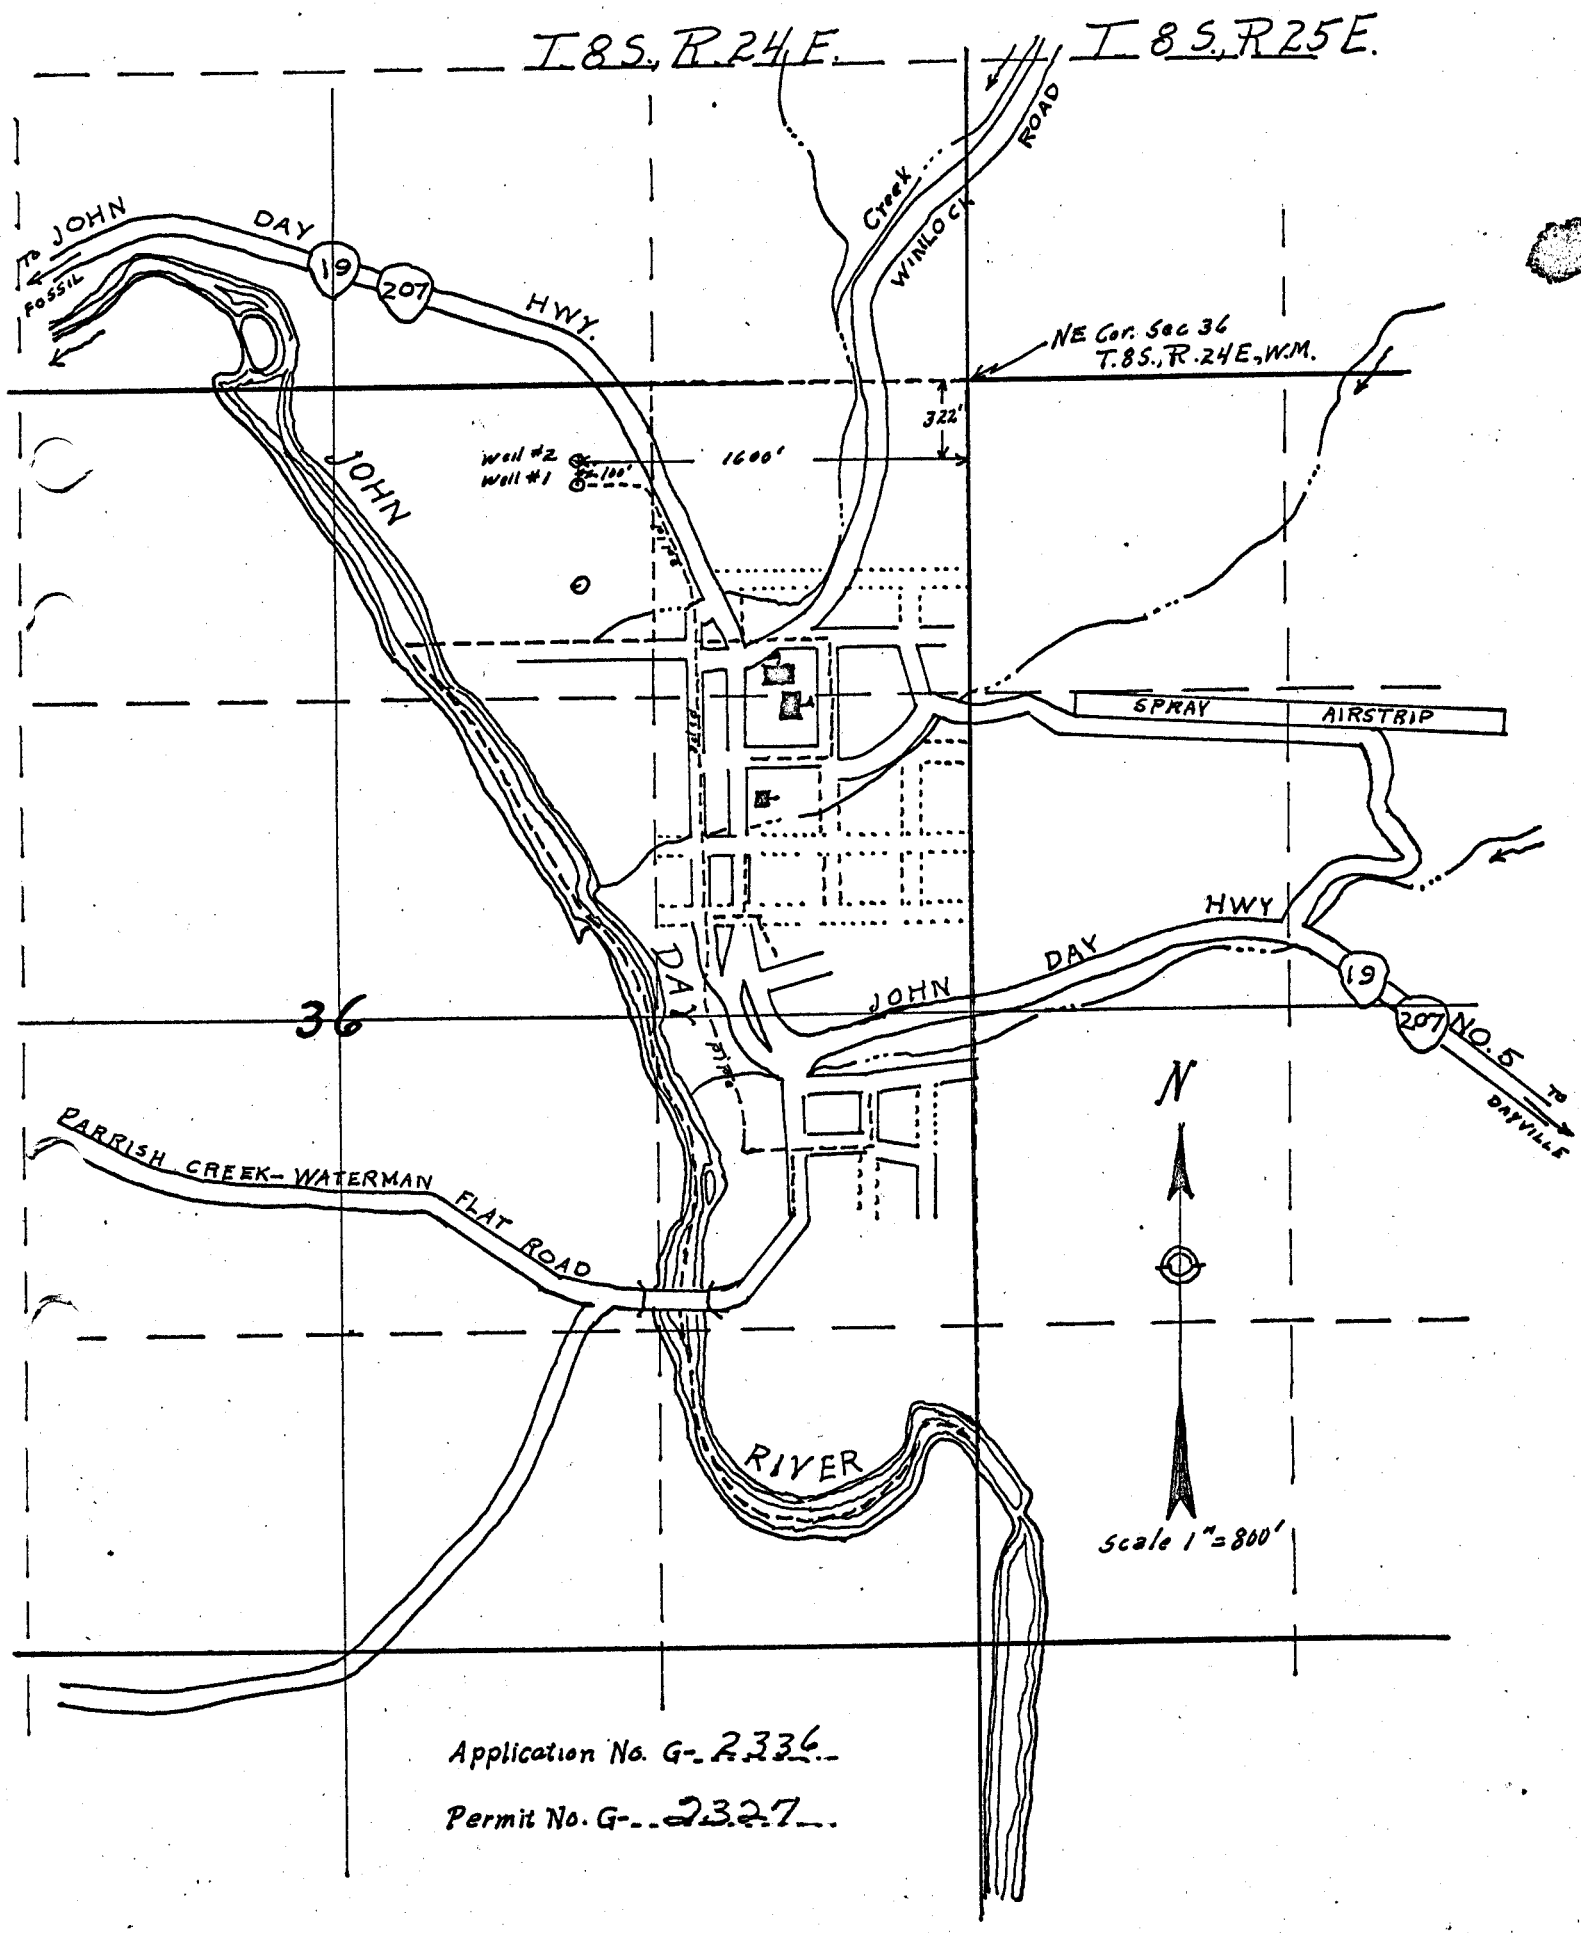

Application No. G-2336
Permit No. G-2327