

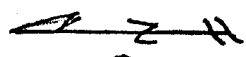
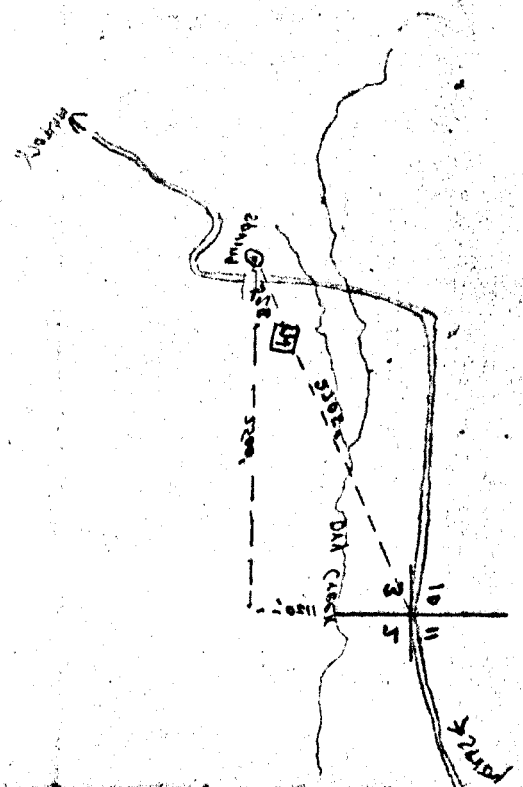


Application No. 42566
 Perm't No. 31809

SE 1/4 of Sec 3
 T8S
 R24E
 H_u = 1W
 2150' 10"

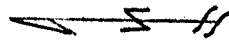

Spring Development
 5/20/66
 4" = 1 mi.
 R24E
 T8S
 M089A-15
 SE 1/4 of Sec 3

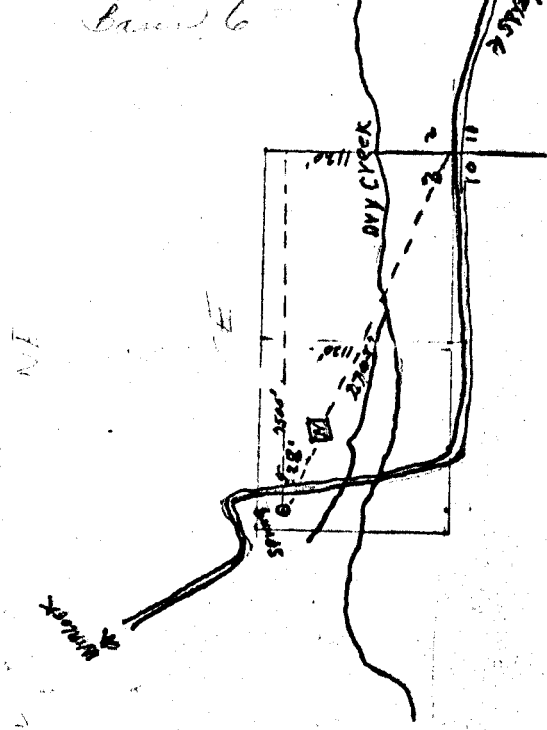

Permit No. 31809
 35789