


T.5S.R.3W.W.M.

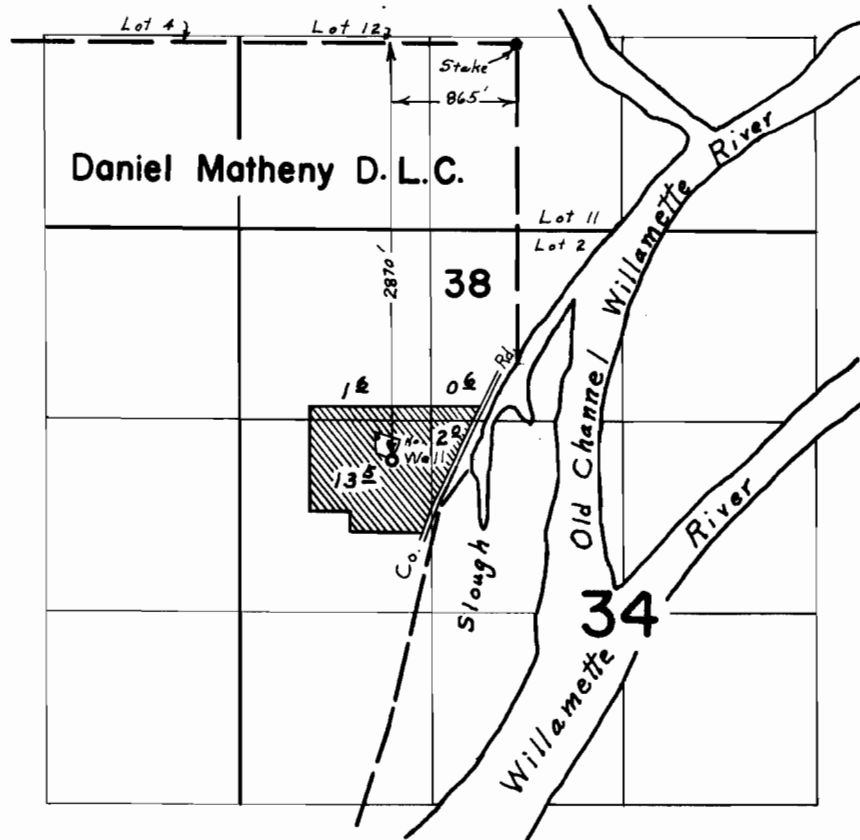

FINAL PROOF SURVEY
UNDER

Application No. G-2681 Permit No. G-2490
IN NAME OF
ROBERT A. & LOUIE W. MAGEE

Surveyed April 5, 1967, by L. E. Gould