


T.5 S.R.3 W.W.M.

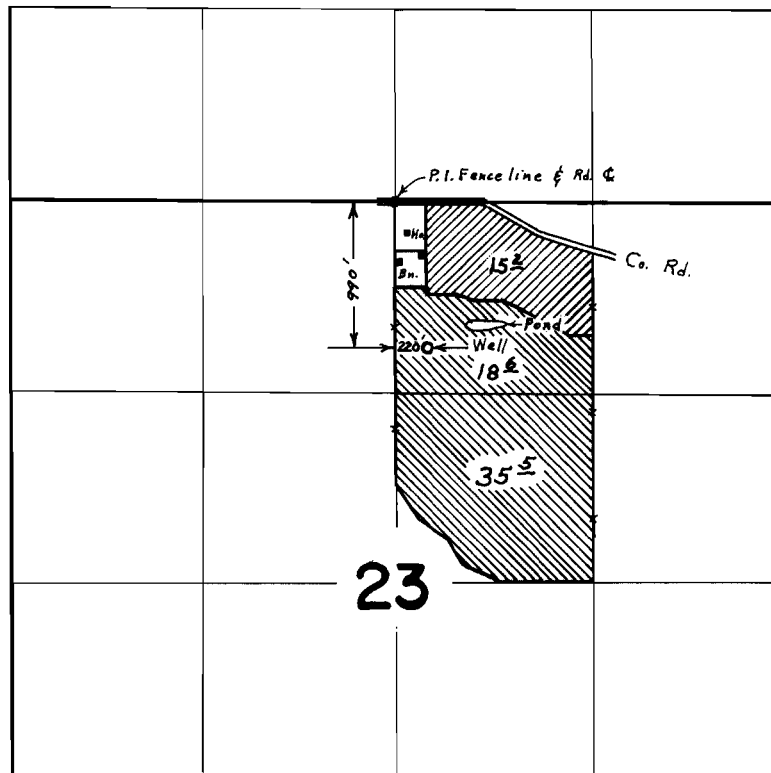

Primary Irrigation
Supplemental Irrigation



FINAL PROOF SURVEY
UNDER

Application No. G-2723 Permit No. G-2547
IN NAME OF
RONALD M. FINNICUM

Surveyed April 7, 1967, by L. E. Gould