


T.5 & 6 S.R.3 W.W.M.

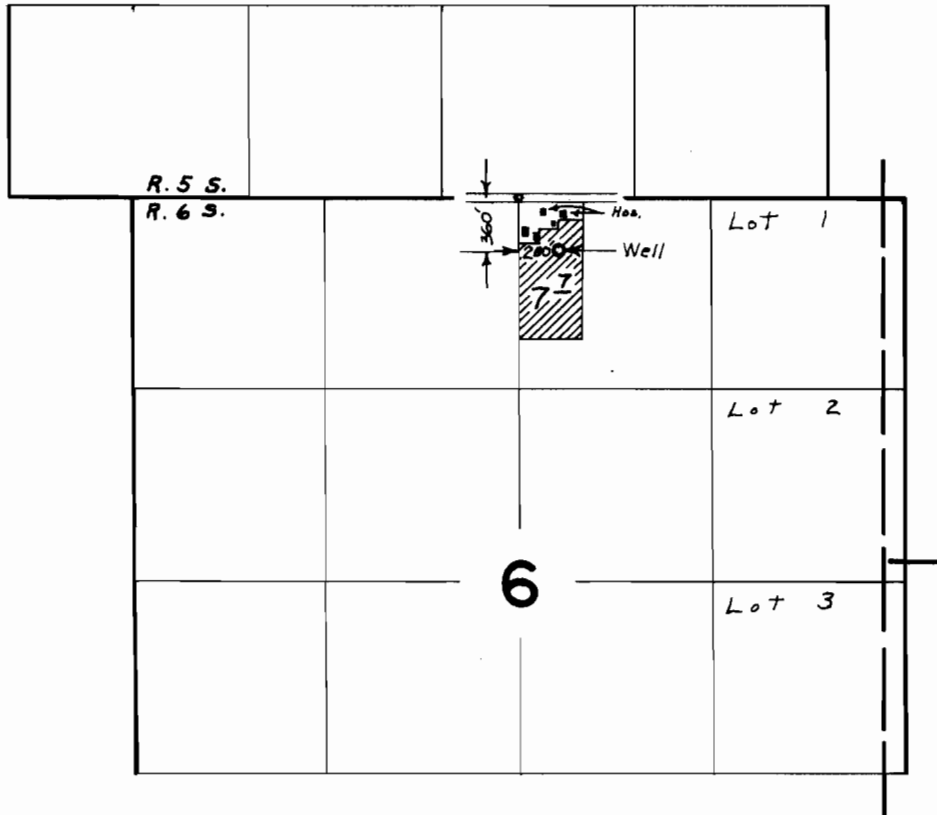

FINAL PROOF SURVEY UNDER

Application No. G-3082 Permit No. G-2879

IN NAME OF

**W. J. & SYLVIA B. ALLEN
AND MARIAN S. KETCHUM**

Surveyed Aug. 11, 1967, by L. E. Gould