


T. 6 S. R. 3 W. W. M.

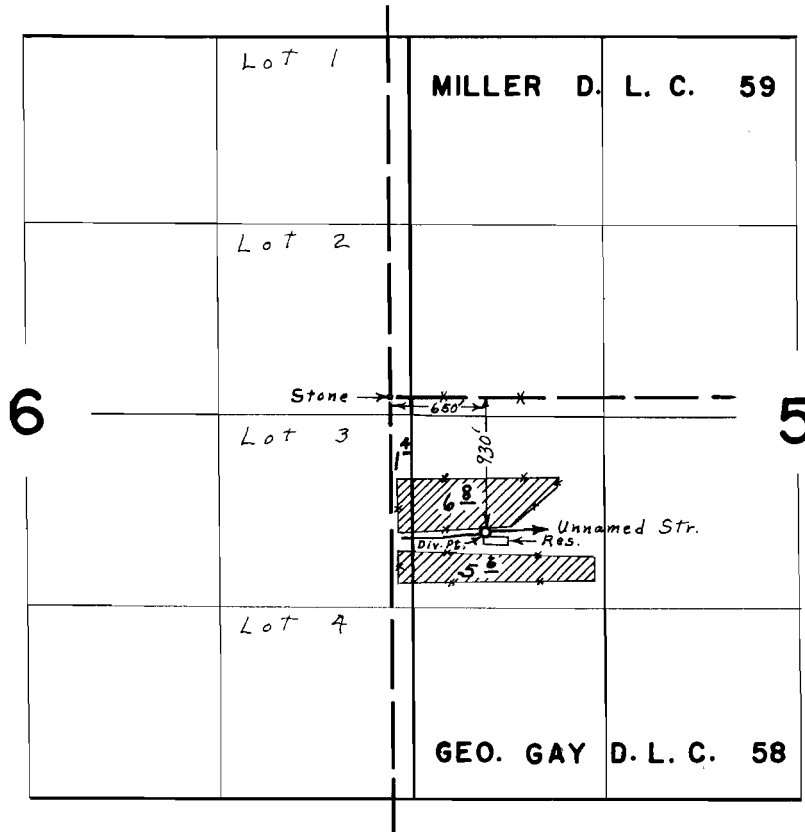

FINAL PROOF SURVEY
UNDER

R-37484 R-2788
Application No. 37485 Permit No. 27905
IN NAME OF

ARTHUR NYGREN

Surveyed Sept. 1, 1967, by L. E. Gould