


T. 6 S. R. 3 W. W. M.

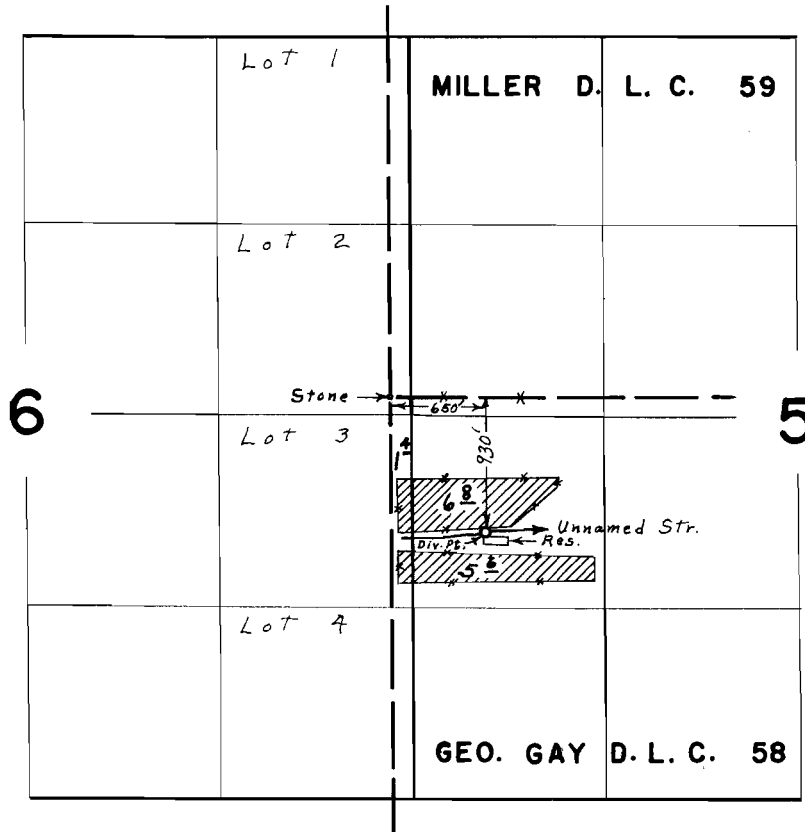

**FINAL PROOF SURVEY**  
UNDER

R-37484 R-2788  
Application No. ~~37485~~ Permit No. ~~27905~~  
IN NAME OF

**ARTHUR NYGREN**

Surveyed Sept. 1, 1967, by L. E. Gould