


# T.5S.R.7 W.W.M.

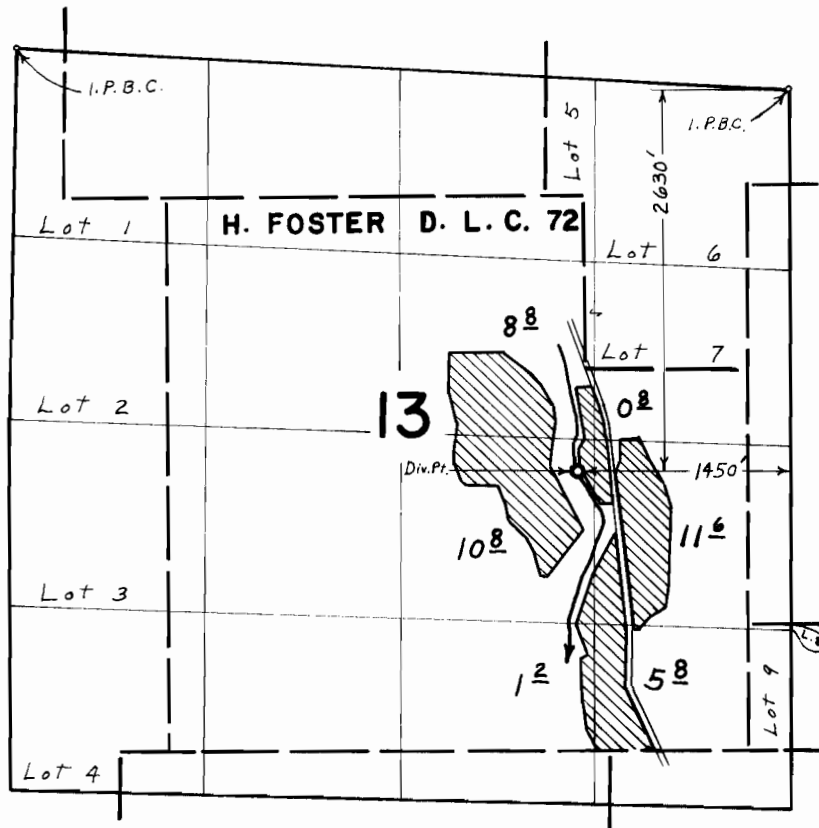

## FINAL PROOF SURVEY UNDER

Application No. 38008 Permit No. 28332  
IN NAME OF

**PEARL J. BLACKWELL**

Surveyed Aug. 9, 1967, by L. E. Gould