


# T.5 S.R.5 W.W.M.

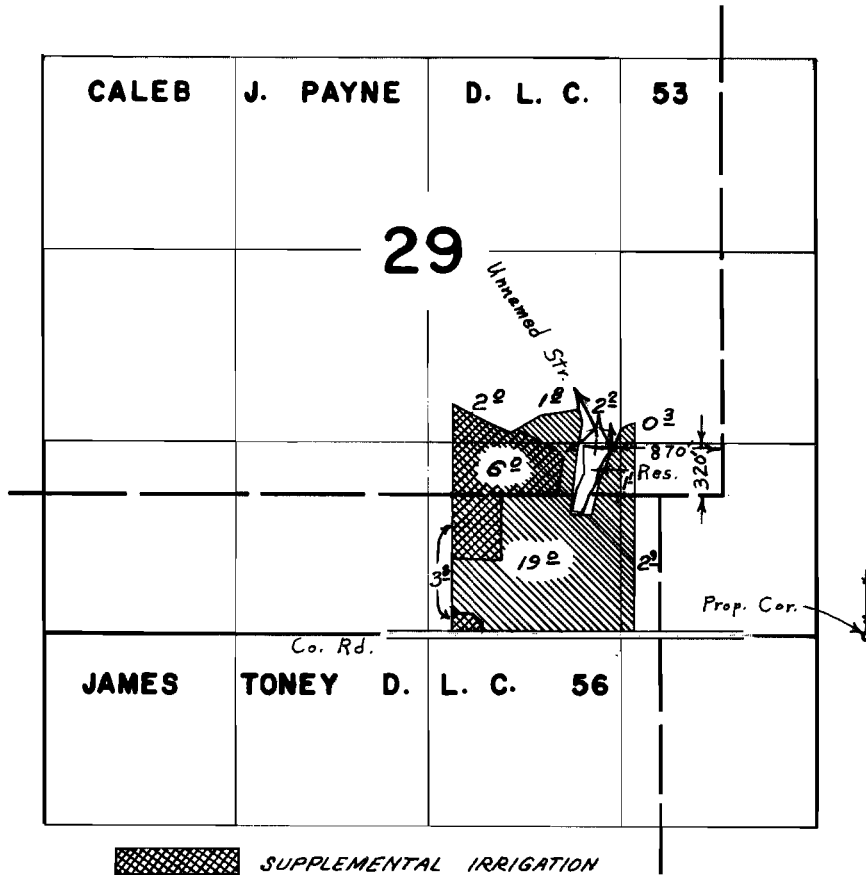

## FINAL PROOF SURVEY UNDER

R-38887  
Application No. 38888... Permit No. 28998...  
IN NAME OF

**CLYDE TODD & HAROLD BUEL**

Surveyed Aug. 11, 1967., by L. E. Gould...