


T.5 S.R.5 W.W.M.

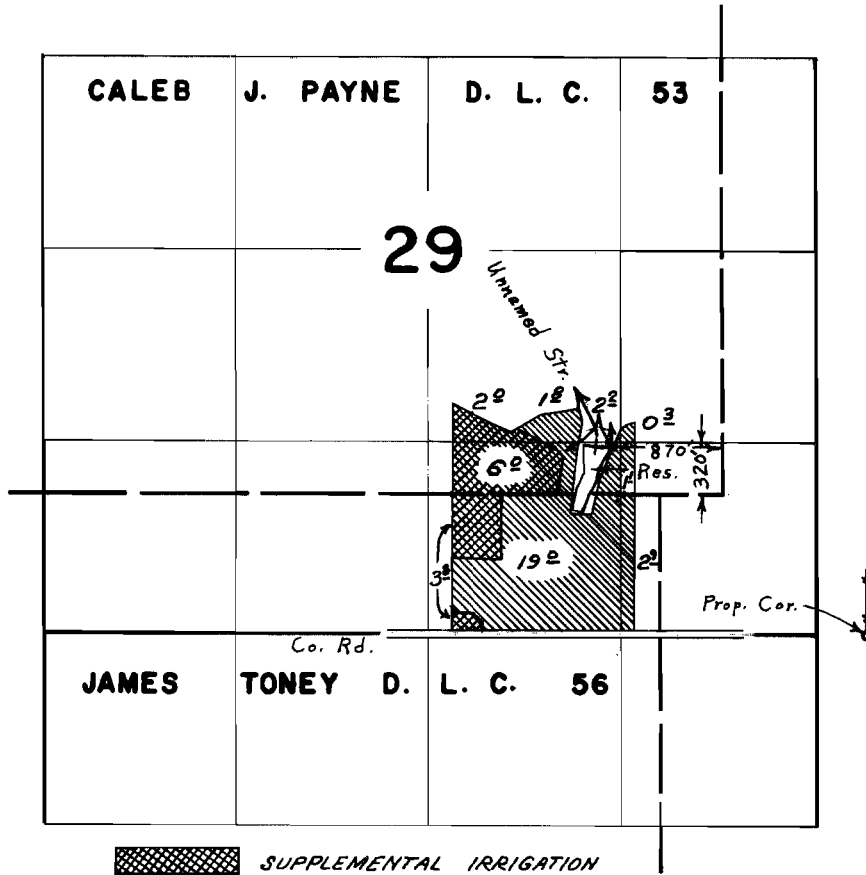

FINAL PROOF SURVEY UNDER

R-38887
Application No. 38888... Permit No. 28998...
IN NAME OF

CLYDE TODD & HAROLD BUEL

Surveyed Aug. 11, 1967., by L. E. Gould...