


# T.5 S.R.7 W.W.M.

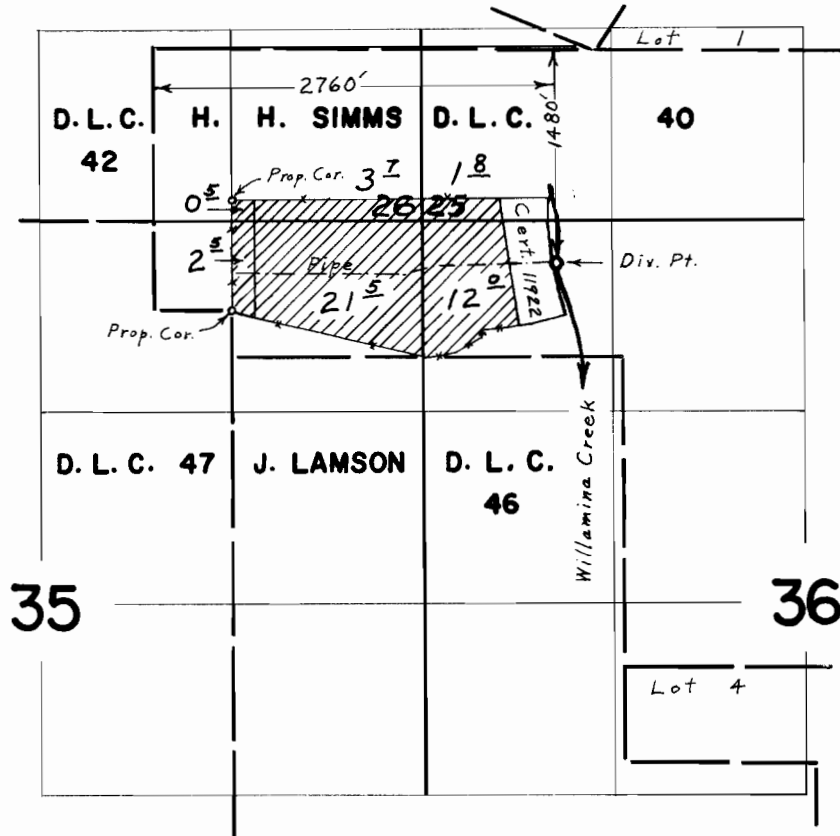

## FINAL PROOF SURVEY UNDER

Application No. 41371 Permit No. 30904  
IN NAME OF  
**GALE SCHMITZ**

Surveyed Aug. 9 1967, by L. E. Gould