


T. 4 S. R. 3 W. W. M.

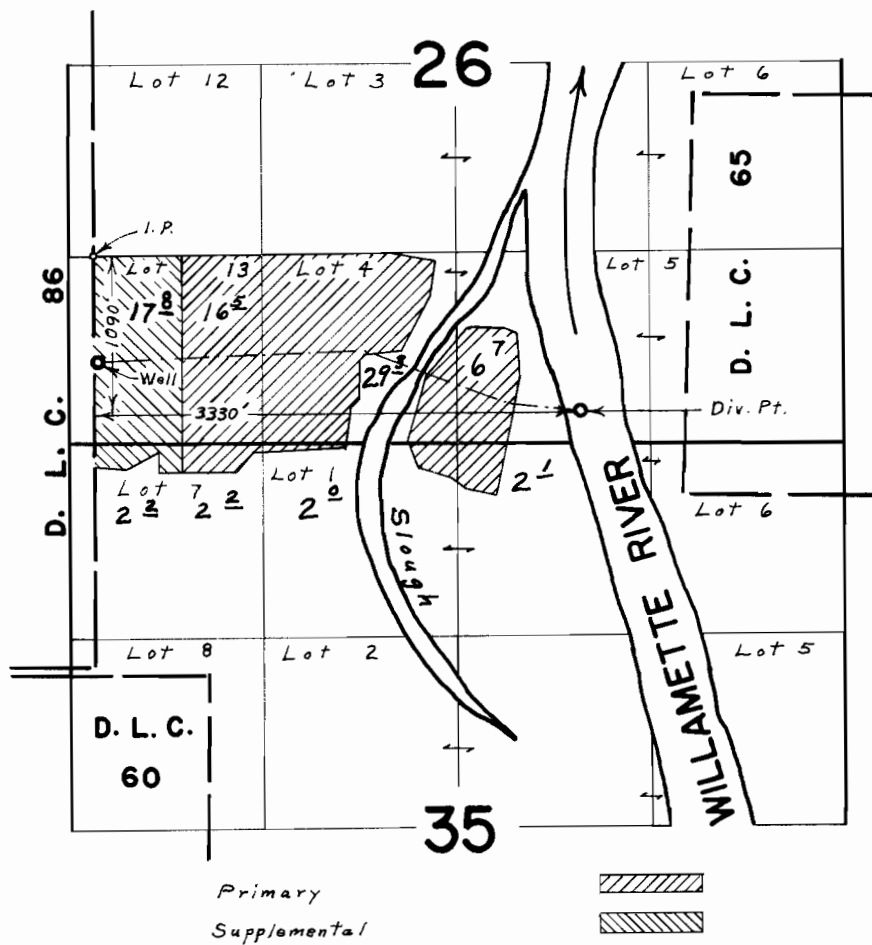

FINAL PROOF SURVEY UNDER

Application No. 41809 Permit No. 31297
 IN NAME OF
HUBERT L. WILSON

Surveyed Sept. 8, 1967, by L. E. Gould