


St. of Sec 25 S 170. N 10 E. NW

cc 25 (center)

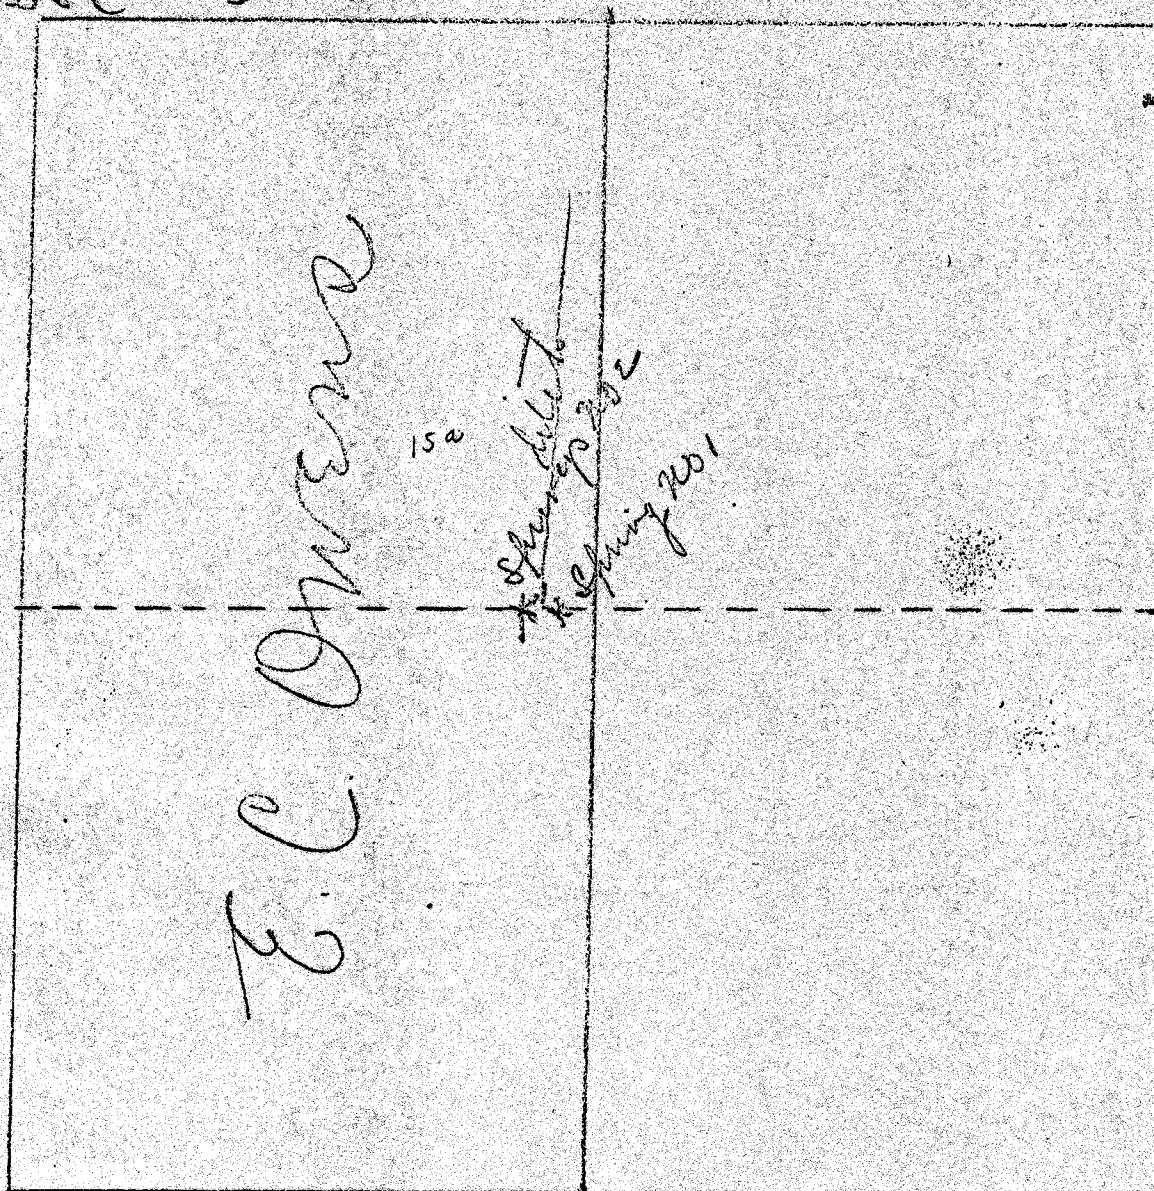

Application No.

6643

Permit No.

4149

OFFICE OF STATE ENGINEER
JUL 16 1913
BIRMINGHAM