


T.36 S. R. 18 & 2 E. W.M.

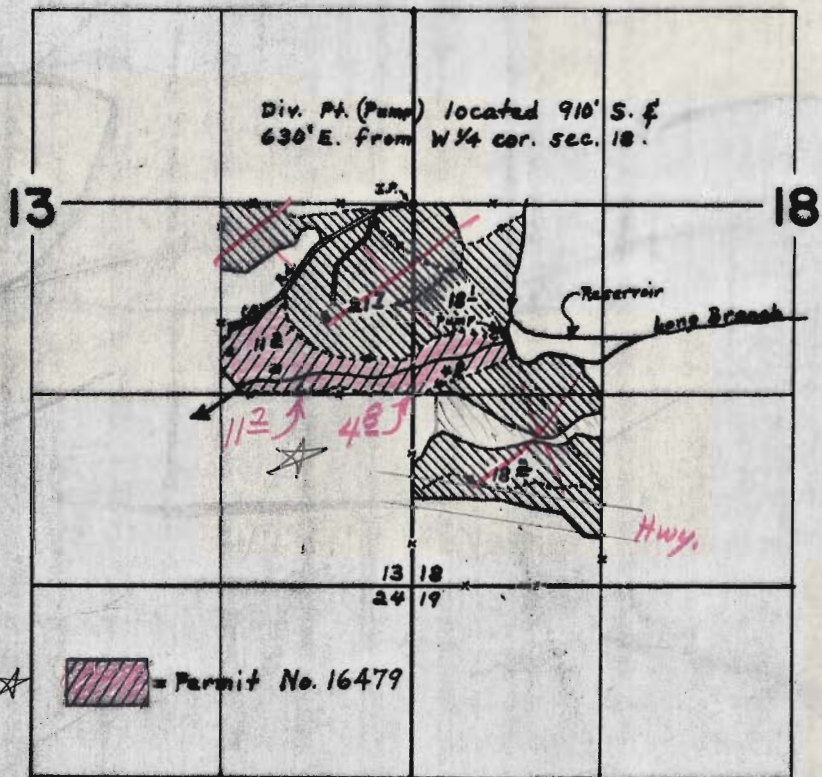

★ See letter to Myron Bish dated Jan 21, 1969 correcting acreage to area shown in red above.
DBX

FINAL PROOF SURVEY UNDER

Permit 16479

Application No. ~~R-30444~~ ~~R-30443~~ Permit No. ~~R-23906~~ ~~R-1803~~
IN NAME OF

CERT. 35804

Priority 7-24-45

THEODORE BLOOMBERG, et al.

Surveyed ~~May 22-25 1967~~ by W. J. Ruppert
June 21, 1967 by D. L. Hendrix