


Township 1 North, Range 10E 11M.

4150

Sec 25 (Center)

W

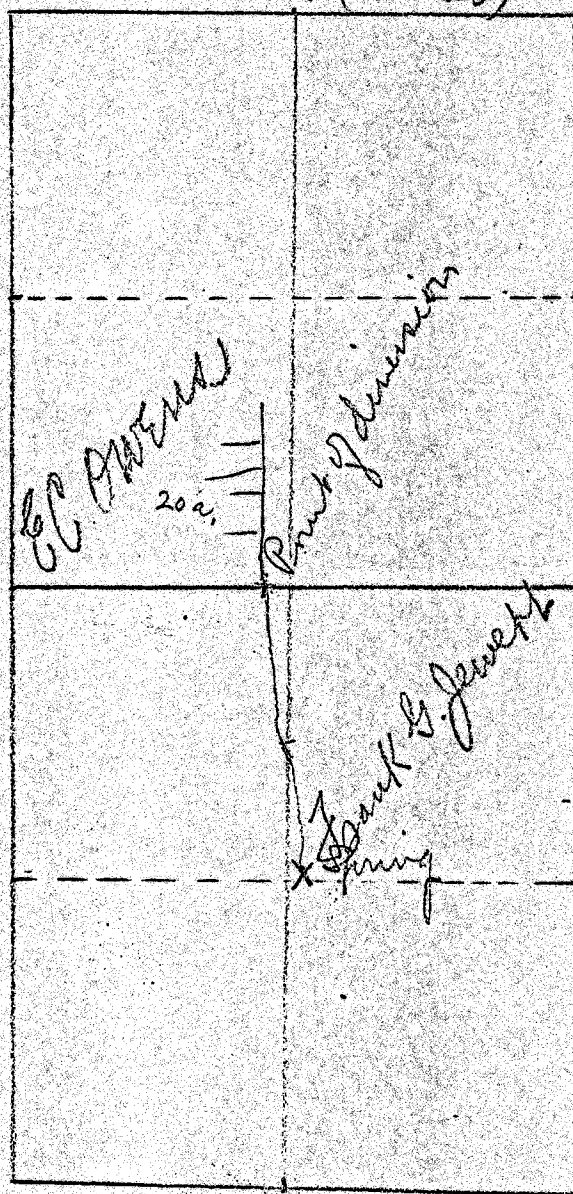

E

E + W line between Sec 25 + 36

Sec 36 (Center)

S

OFFICE OF STATE ENGINEER

RECEIVED

JUL 16 1919

ST. LOUIS, MO. CHAS. C.

Application No. ~~6644~~ 6644

Permit No. ~~4140~~ 4150