


T. 5 S. R. 3 W. W.M.

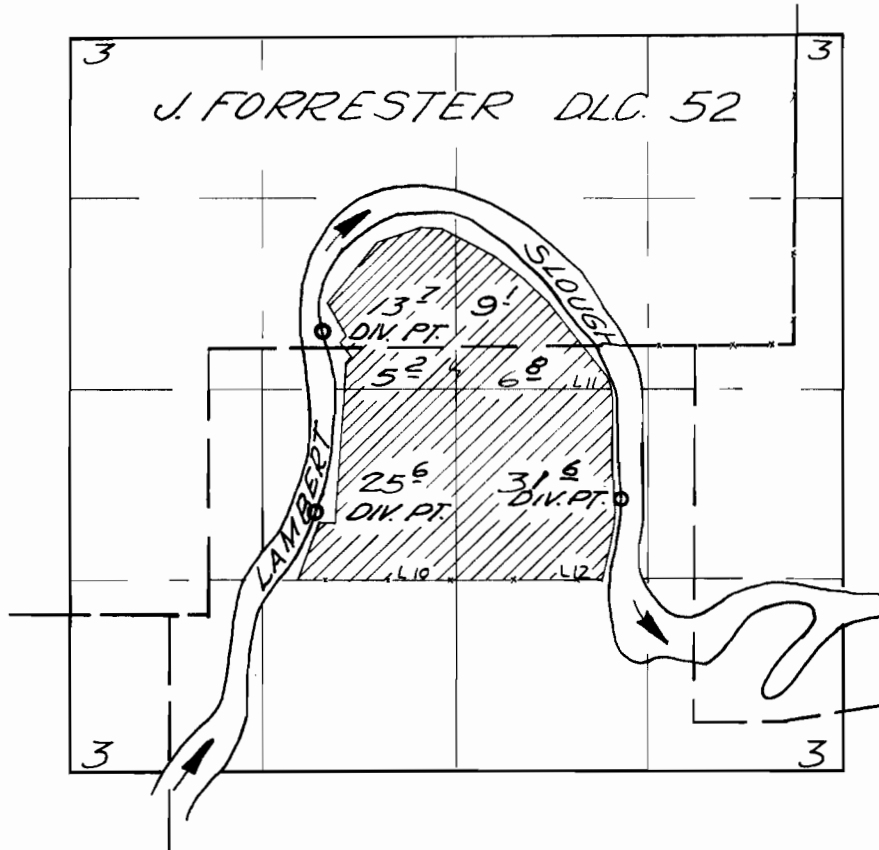

FINAL PROOF SURVEY
UNDER

Application No. *18111* Permit No. *13847*
IN NAME OF

U.S. ALDERMAN

Surveyed *May 1, 1941*, by *C. A. CUMMINGS*