


T.26S.R.12W. W.M.

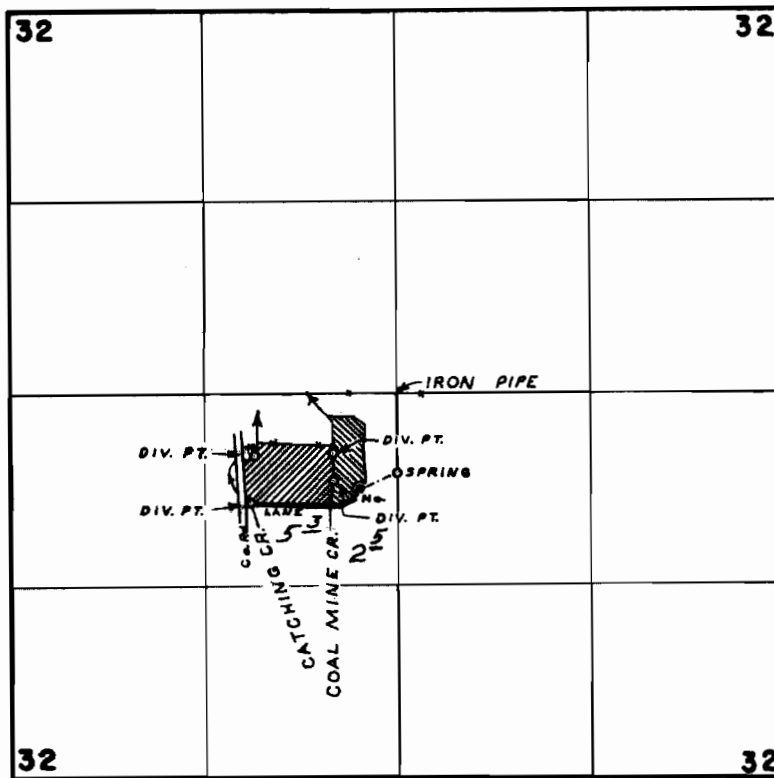

DIV. PTS. LOCATED; 410'S & 440' W.; 590'S & 430' W.; 750'S
1010' W.; 430'S & 970' W.; ALL FROM CENTER SEC. 32

FINAL PROOF SURVEY UNDER

Application No. 40174... Permit No. 29946
IN NAME OF

BERTHA E. CROOKS

Surveyed **SEPT. 20 1968**, by **L. E. GOULD**