


T. 28 S. R. 14 W. W. M.

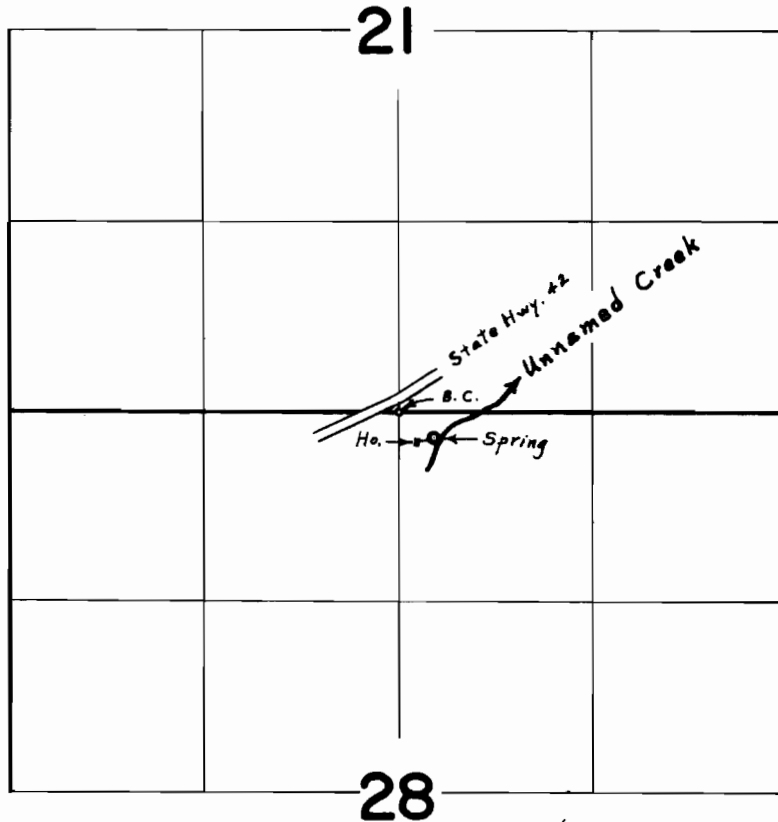

Spring located 180' S. & 240' E. from N.  $\frac{1}{4}$  Cor. Sec. 28

**FINAL PROOF SURVEY**  
UNDER

Application No. 40266 Permit No. 29957  
IN NAME OF  
**JAMES F. MAUZEY**

Surveyed July 16, 1968, by L. E. Gould