


T. 16S. R. 22E. W.M.

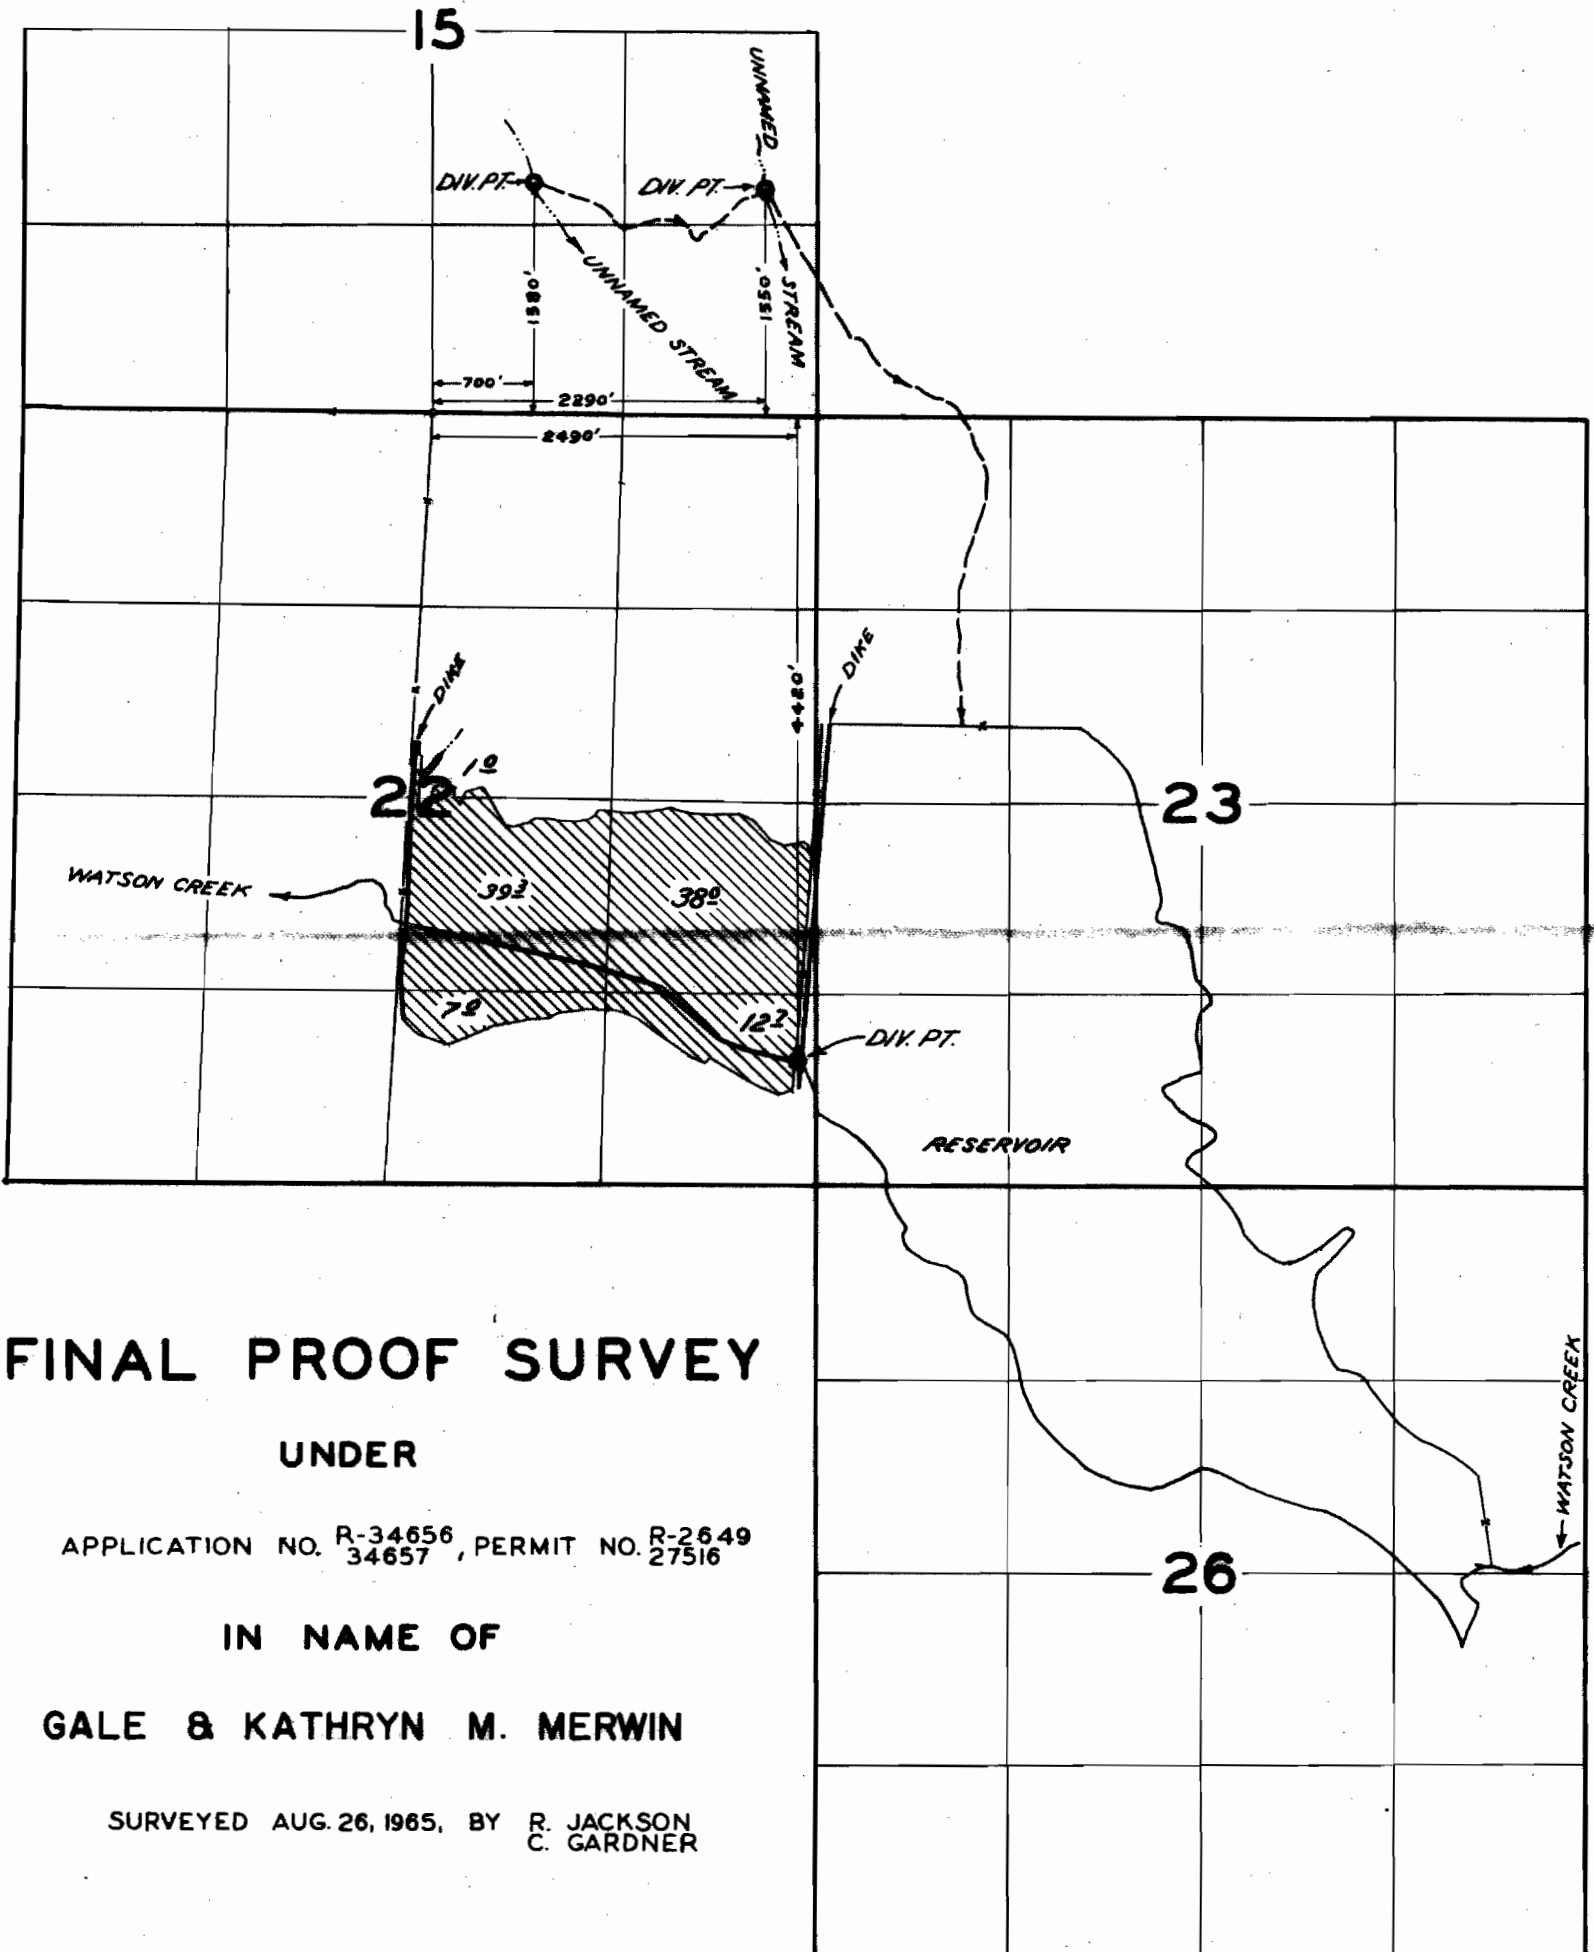

FINAL PROOF SURVEY

UNDER

APPLICATION NO. R-34656, PERMIT NO. R-2649
34657, 27516

IN NAME OF

GALE & KATHRYN M. MERWIN

C. GARDNER