


T.35S.R.11&12W.W.M.

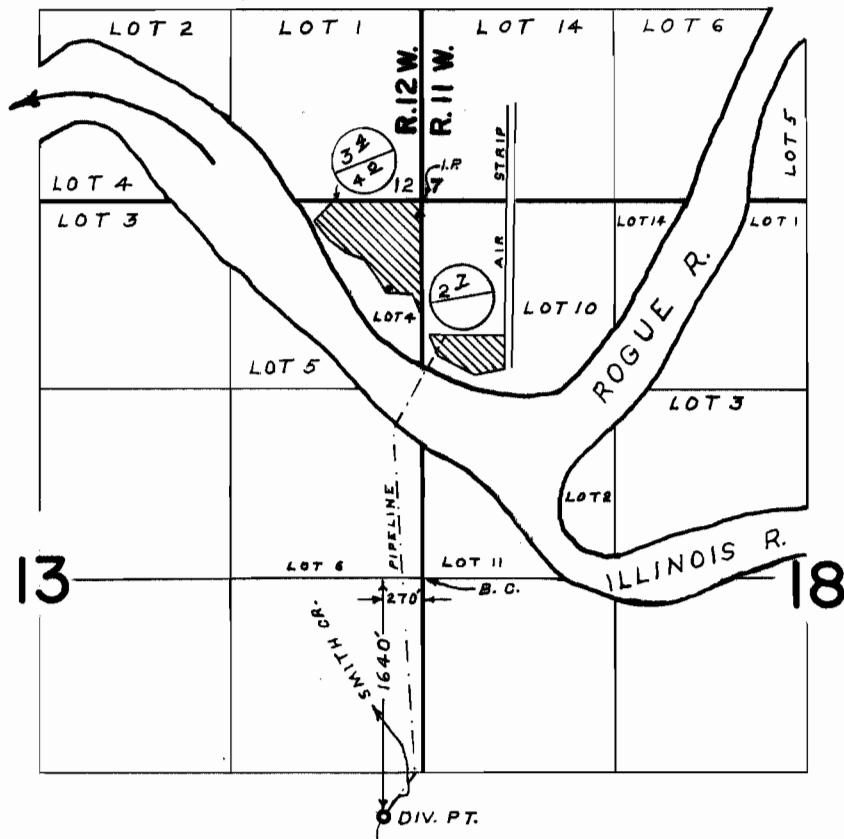

PRIMARY → (circle with arrow)
SUPPLEMENTAL → (circle with arrow)

FINAL PROOF SURVEY UNDER

Application No. 38365 Permit No. 28926
IN NAME OF

LARRY LUCAS

Surveyed SEPT. 16 1968, by L. E. GOULD