


T.26S. R.3W. W.M.

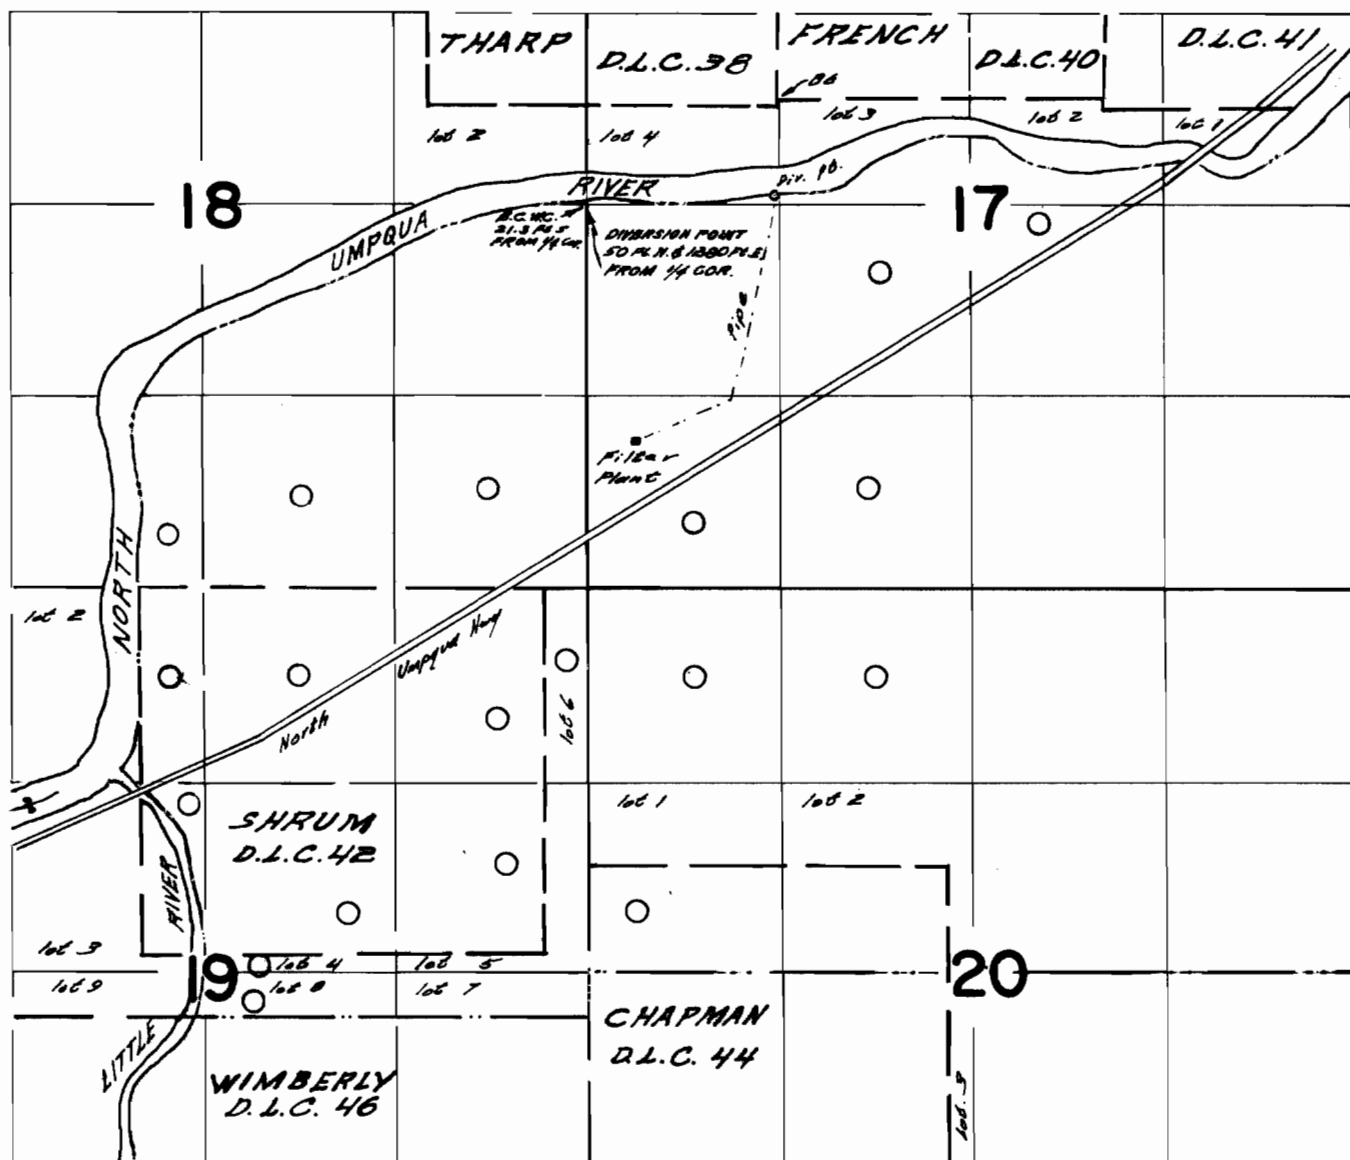

COOPERATIVE BOUNDARY

○ indicates use within 1/4 1/4 Section

FINAL PROOF SURVEY UNDER

Application No. 34230 Permit No. 27403
IN NAME OF

GLIDE WATER COOP. USERS ASSOC.

Surveyed MAY 9 1967, by W. d. Rupperts
June 27, 1968