


T. 27 S. R. 4 W. W.M.

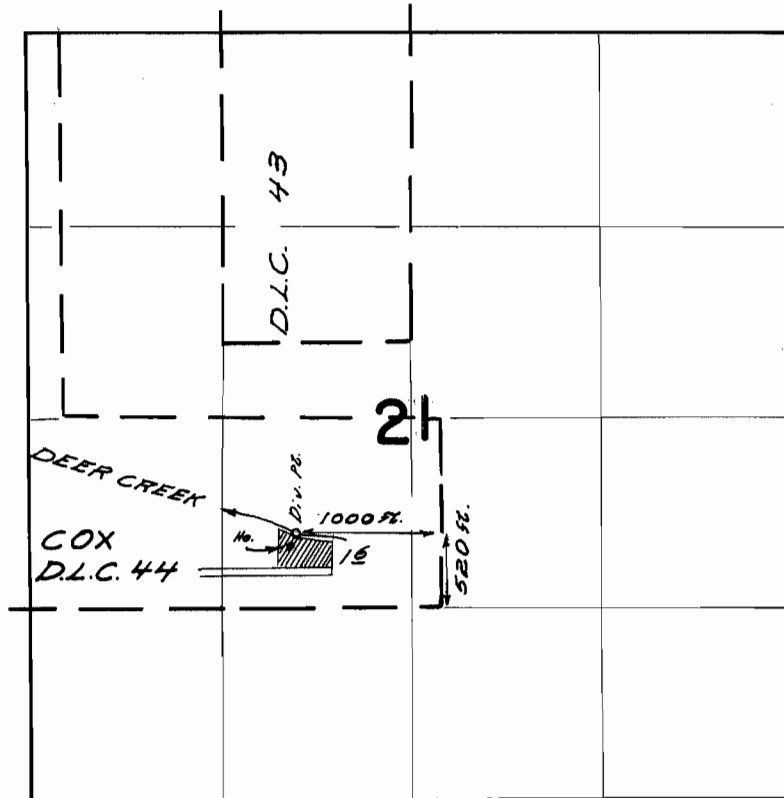

FINAL PROOF SURVEY
UNDER

Application No. 37855 Permit No. 28361
IN NAME OF

Jay K. & Sally Hovey

Surveyed April 17, 1967, by W. d. Ruppert
June 27, 1968