


T.26S. R.4W. W.M.

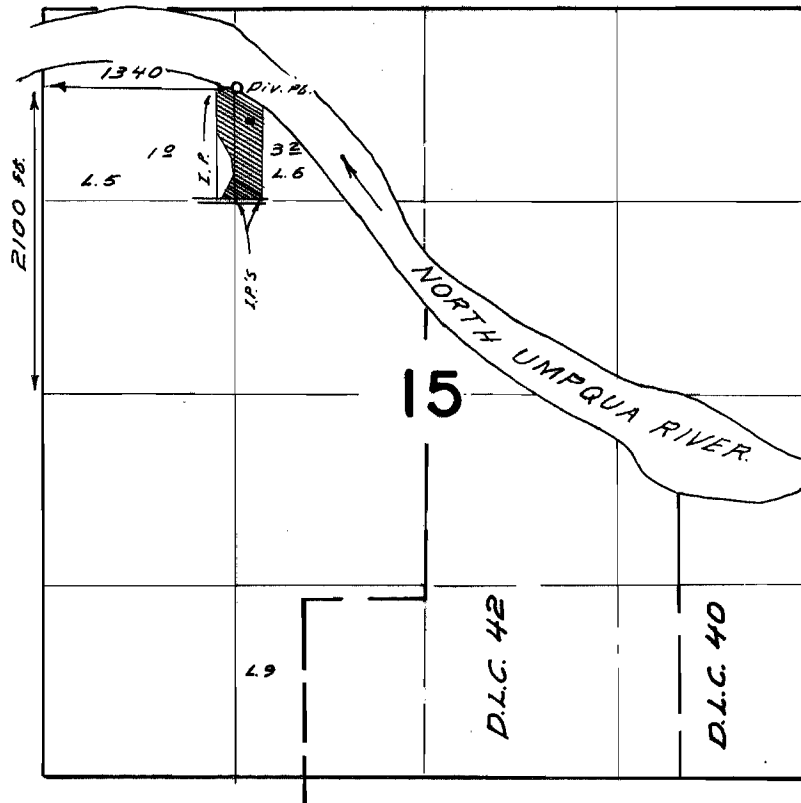

FINAL PROOF SURVEY
UNDER

Application No. 38333 Permit No. 28578
IN NAME OF

James E. Slattery

Surveyed April 12 1967, by W. d. Ruppert
June 28, 1968