


T.32S.R.6W.W.M.

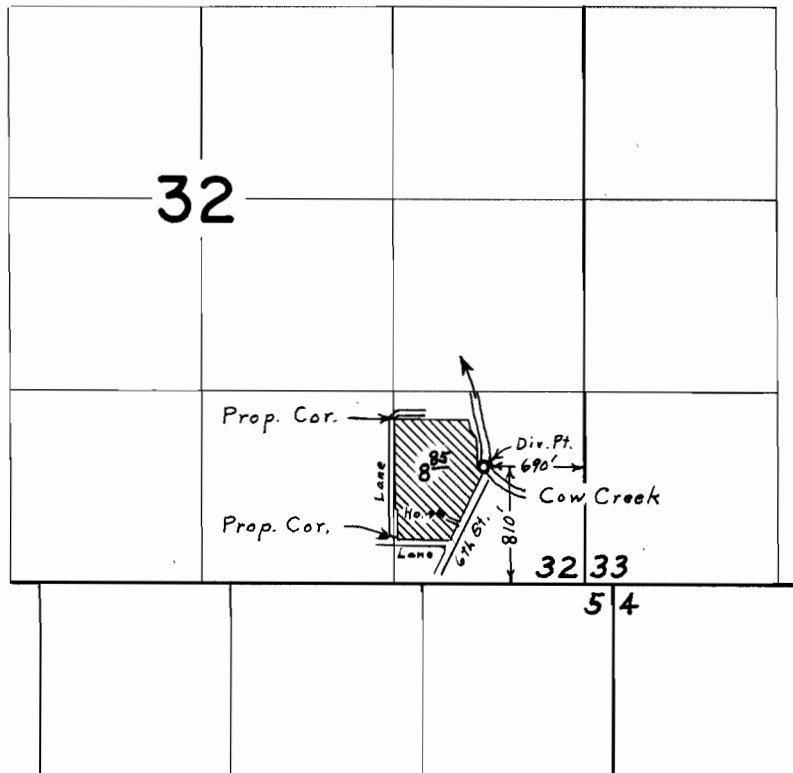

**FINAL PROOF SURVEY**  
UNDER

Application No. 38353 Permit No. 28585  
IN NAME OF

**HARLEY A. MILLER**

Surveyed May 1, 1968, by L. E. Gould