


T. 26 S. R. 2 W. W.M.

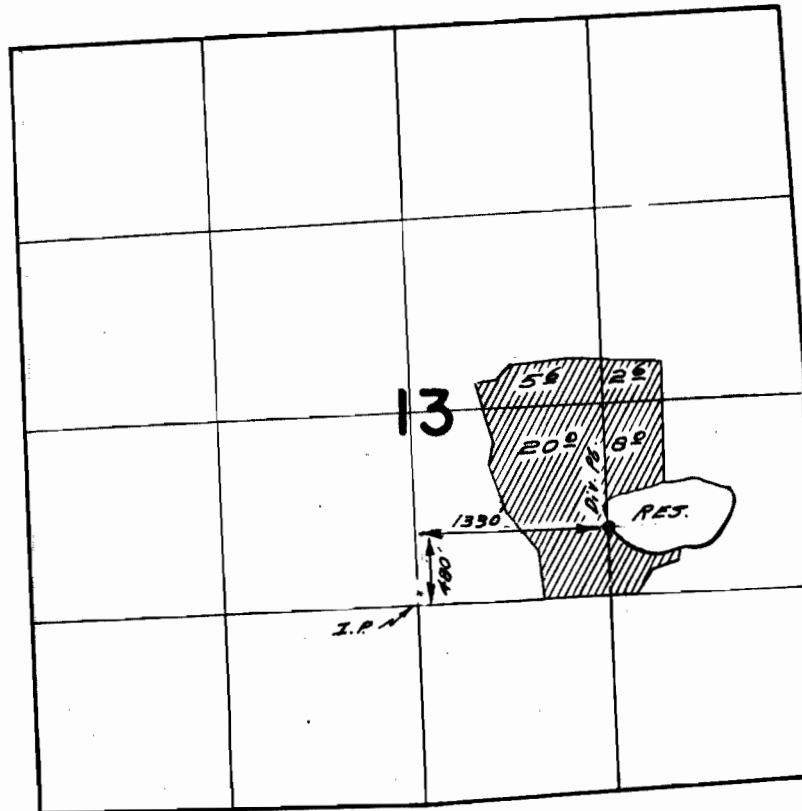

**FINAL PROOF SURVEY**  
UNDER

40388

30121

Application No. R-40390 Permit No. R-4515  
IN NAME OF

Estle L. Paris

Surveyed June 6 1967, by W. J. Ruppert  
June 27, 1968