


T. 26 S. R. 2 W. W.M.

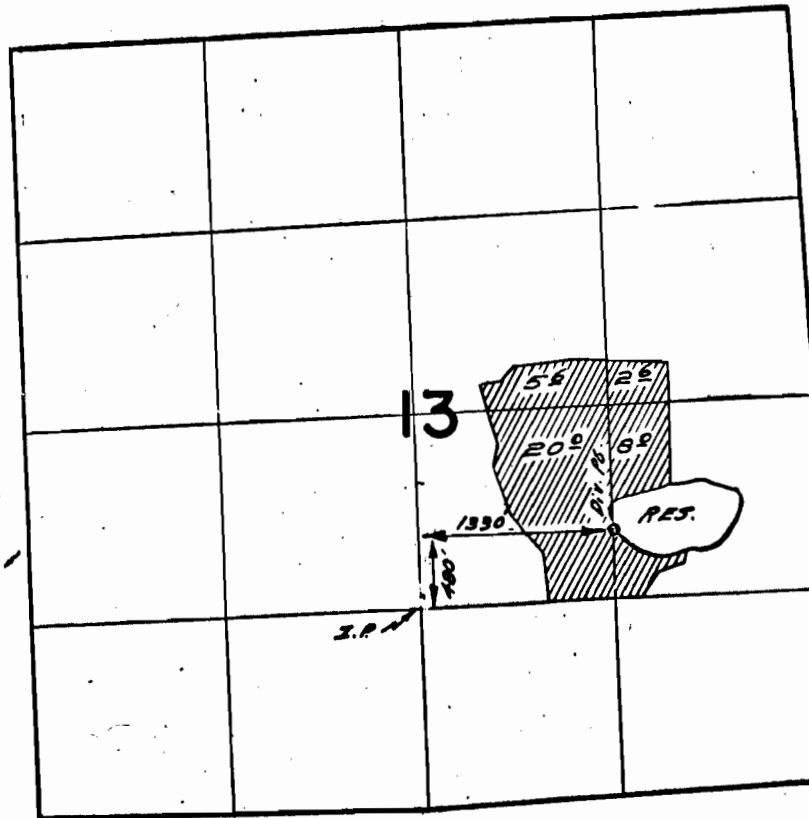

FINAL PROOF SURVEY
UNDER

40388

30121

Application No. R-40390 Permit No. R-4515
IN NAME OF

Estle L. Paris

Surveyed June 6 1967, by M. J. Pappas
June 27, 1968