


T. 22 S. R. 7 W. W.M.

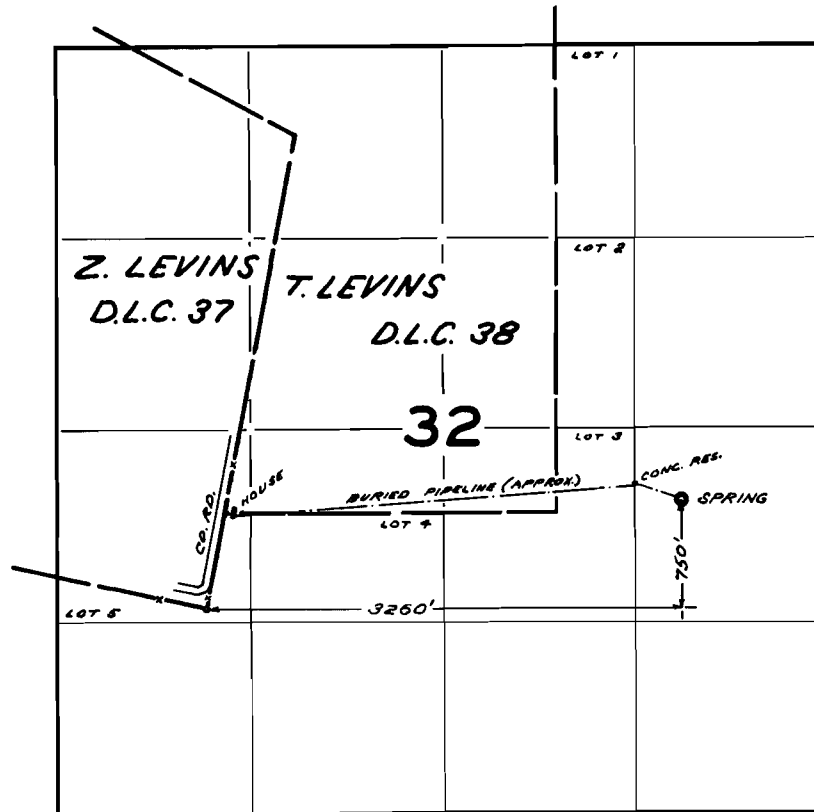

FINAL PROOF SURVEY
UNDER

Application No. 40738 Permit No. 30341
IN NAME OF

CHARLEY SOLOMAN

Surveyed MAY 2 1968, by V. GARNER