


T.33S.R.6W.W.M.

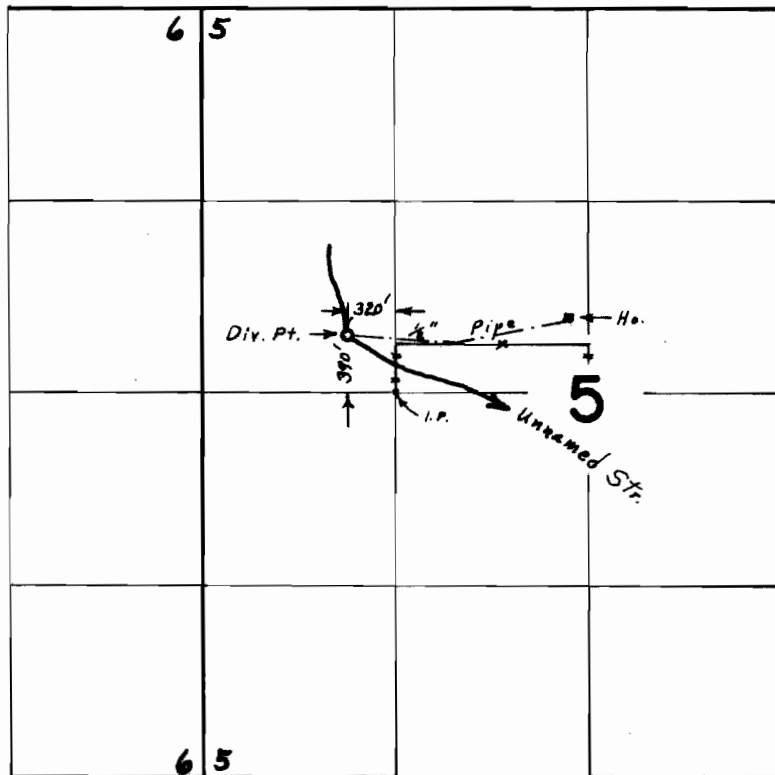

FINAL PROOF SURVEY
UNDER

Application No. 41379 Permit No. 30911
IN NAME OF

CALVIN LEE MUNYON

Surveyed May 2, 1968, by L. E. Gauld