


T.33 S.R.6 W.W.M.

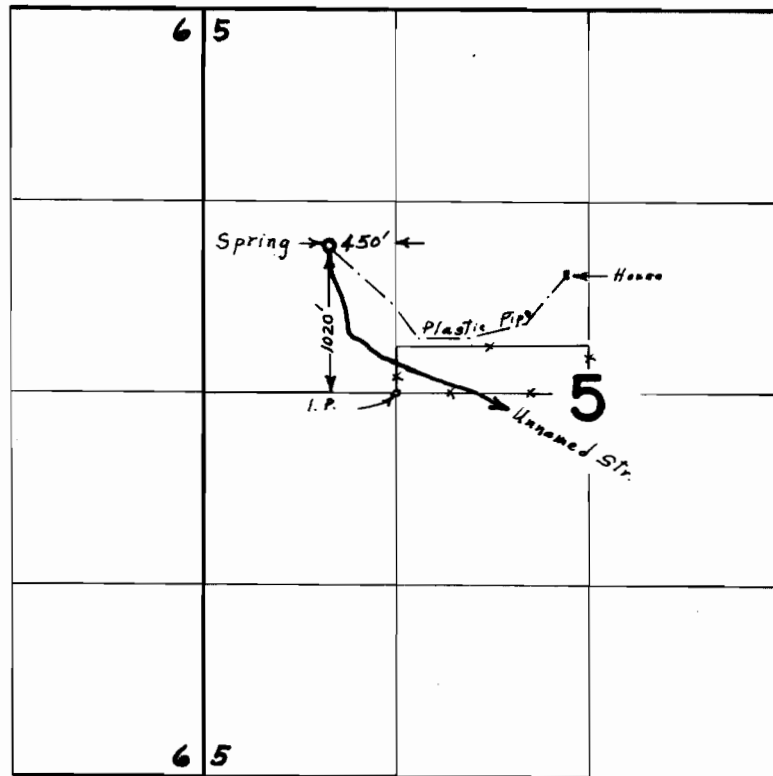

FINAL PROOF SURVEY
UNDER

Application No. 42407 Permit No. 31670
IN NAME OF
ROY WILLIAMSON

Surveyed May 3, 1968, by L. E. Gould