


T. 34 S. R. 34 E. W.M

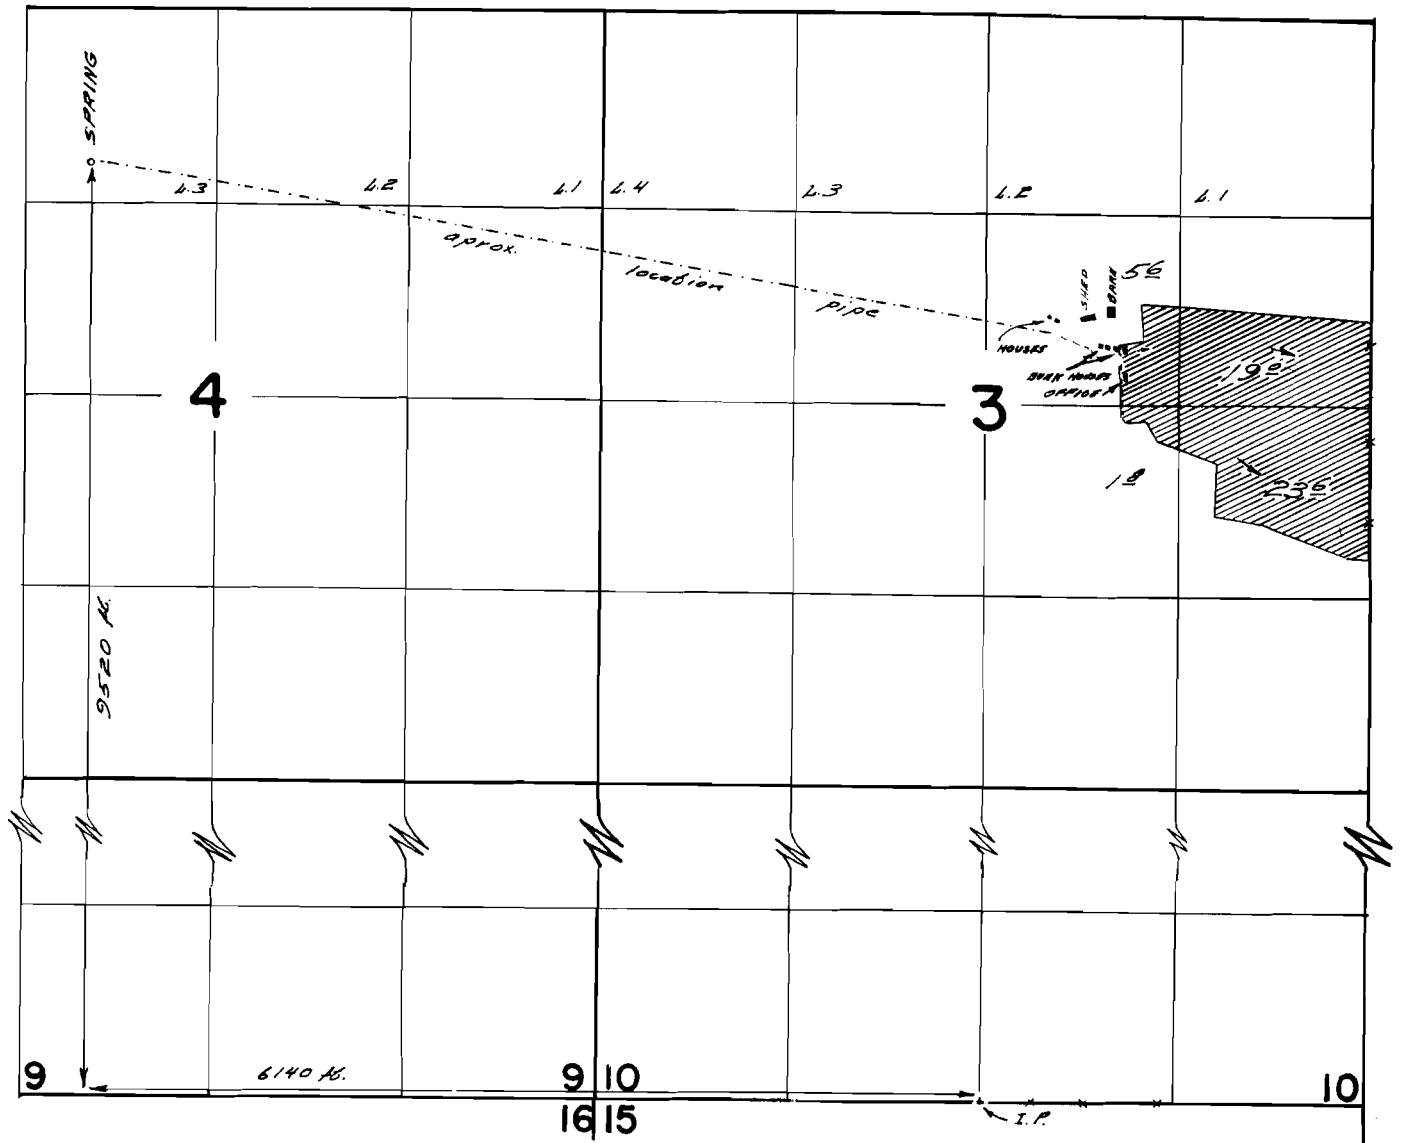

FINAL PROOF SURVEY  
UNDER

Application No. 20354 Permit No. 17215  
IN NAME OF

ROBERT B. & CONSTANCE H. WILSON

Surveyed Oct. 12, 1967, by W. J. Ruppert