


T. 36S.R. 2W.W.M.

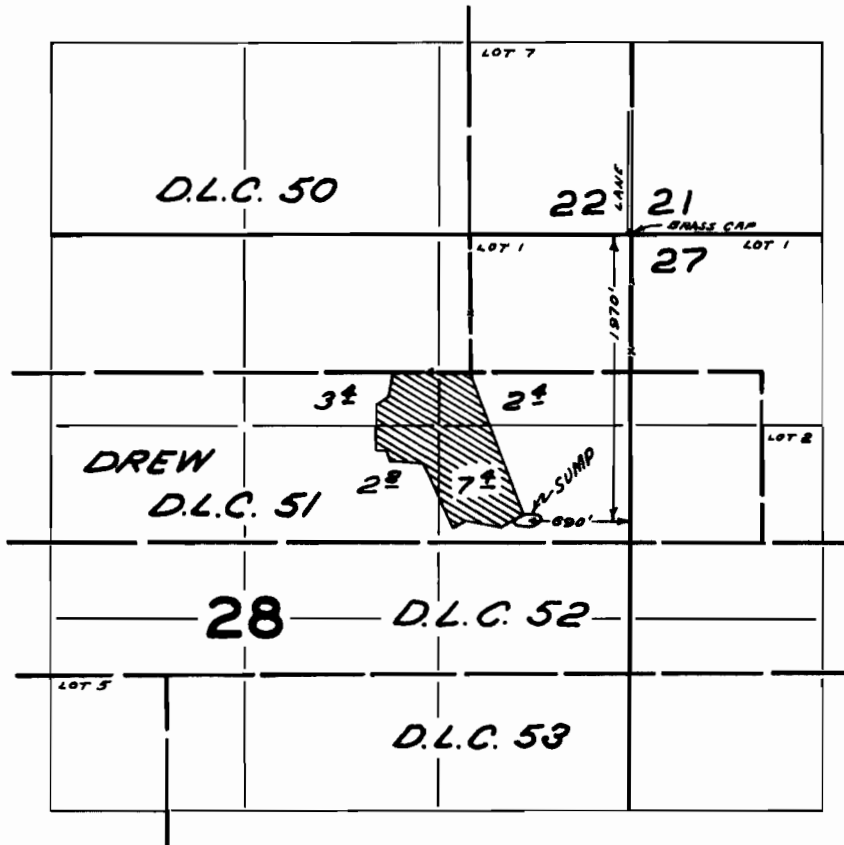

FINAL PROOF SURVEY
UNDER

Application No. G-2582 Permit No. G-2394
IN NAME OF

DEANE OWENS

Surveyed JUN. 6 1968, by V. GARNER