


T. 37S.R.2E.W.M.

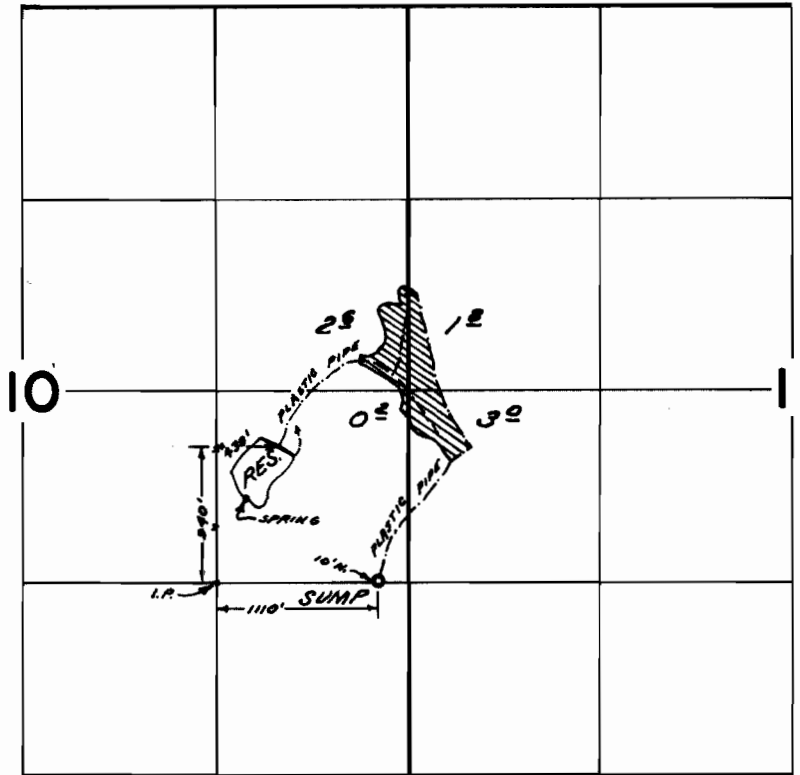

**FINAL PROOF SURVEY**  
UNDER

Application No. 40271 Permit No. 30023  
G-2789 R-40270 G-2599 R-4499

IN NAME OF

PAUL K. AND LORETTA BENDER

Surveyed JUN 13 1968 by V. GARNER