


T. 37S. R. 2E. W.M.

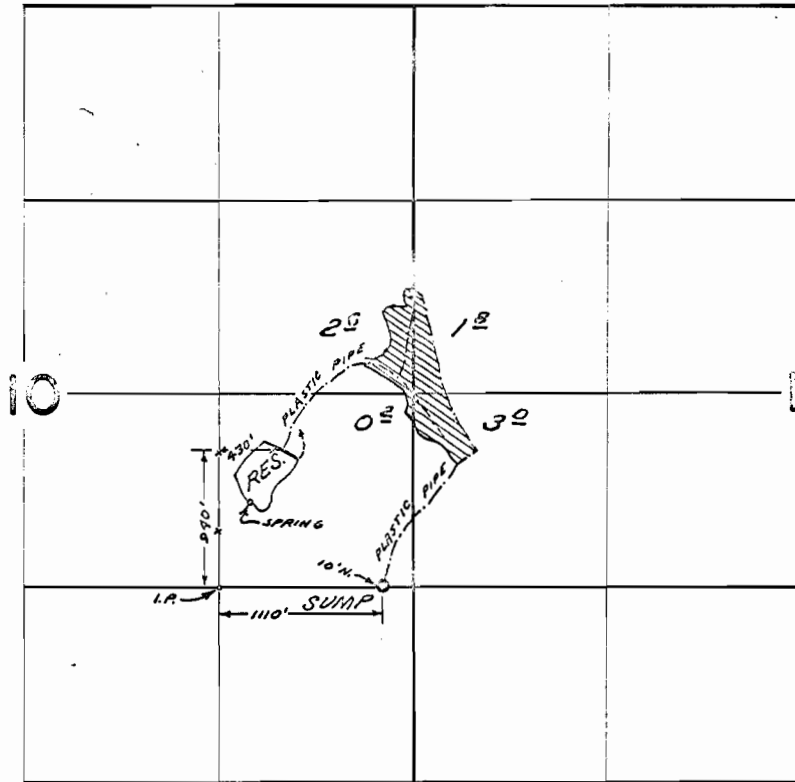

**FINAL PROOF SURVEY**  
UNDER

Application No. G-2789 R-40270 40271 Permit No. G-2599 R-4499 30023  
IN NAME OF

PAUL K. AND LORETTA BENDER

Surveyed JUN 13 1968, by V. GARNER