


T. 37S.R.2E.W.M.

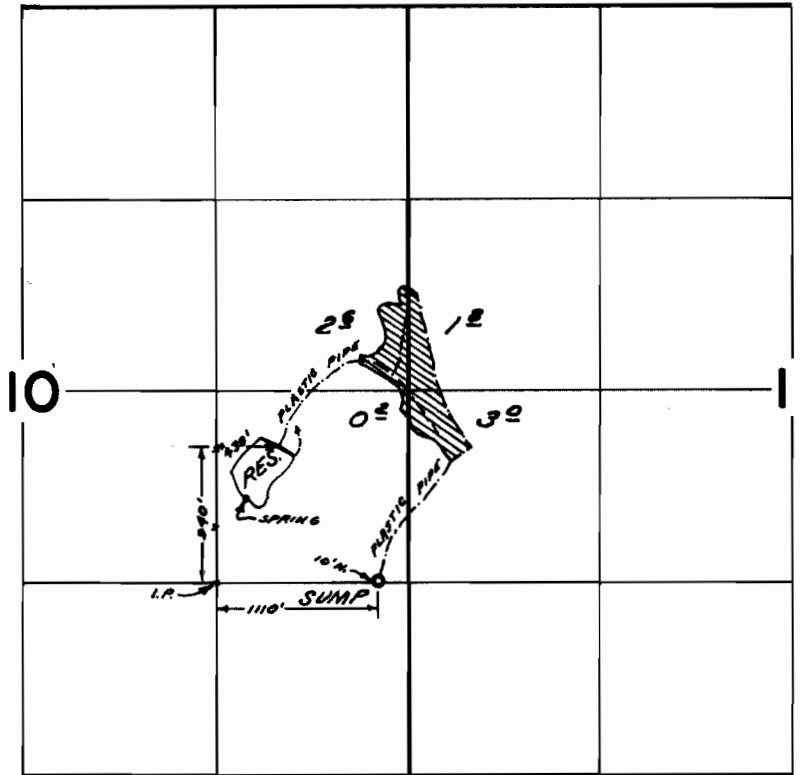

FINAL PROOF SURVEY
UNDER

Application No. G-2789 R-40270 40271 Permit No. G-2599 R-4499 30023

IN NAME OF

PAUL K. AND LORETTA BENDER

Surveyed JUN 13 1968, by V. GARNER