


T. 35 S. R. 1 & 2 W. W. M.

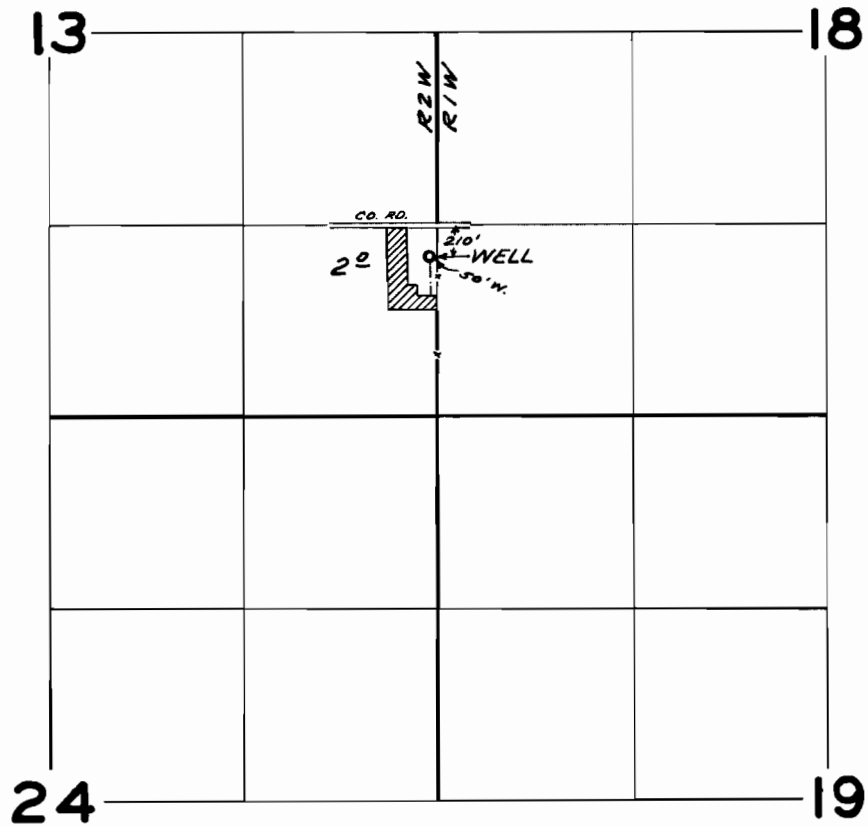

FINAL PROOF SURVEY
UNDER

Application No. G-3257 Permit No. G-3056
IN NAME OF

GERALD M. ANDERSON

Surveyed JUN. 12 1968, by V. GARNER